DUC	CT CON	FIGURATIONS		HVAC SYMBOLS		ABBREV	'IATIC	DNS
SINGLE LINE	DOUBLE LINE	IDENTIFICATION	SYMBOL	IDENTIFICATION	ABBRV.	IDENTIFICATION	ABBRV.	IDENTIFICATION
)				DUCT; SINGLE-LINE	ø	DIAMETER	ID	INSIDE DIAMETER
		LONG SWEEP 90° ELBOW - RECTANGULAR, ROUND OR OVAL		DOCT, SINGLE-LINE	&	AND	IN	INCH
		RECTANGULAN, NOOND ON OVAL		DUCT; DOUBLE-LINE	@	AT	KW	KILOWATTS
	,				°F	DEGREES FAHRENHEIT	LAT	LEAVING AIR TEMPERATURE
		SHORT SWEEP 90° ELBOW -		45 DEGREE DUCT ELBOW; SINGLE-LINE	AC AC/H	AIR CONDITIONER  AIR CHANGES PER HOUR	LBS LRA	POUNDS LOCKED ROTOR AMPS
		RECTANGULAR, ROUND OR OVAL	<b>&gt;</b>	DUCT TRANSITION; SINGLE-LINE	AFF	ABOVE FINISH FLOOR	LVG	LEAVING
J.	<b>-</b> /				AFUE	ANNUAL FUEL UTILIZATION EFFICIENCY	LWT	LEAVING WATER TEMPERATURE
		45° LATERAL - ROUND TO ROUND OR		DUCT TRANSITION; DOUBLE-LINE	AMP	AMPERE	LWB	LEAVING WET BULB
		OVAL TO OVAL		DUCT TRANSITION RECTANGULAR TO ROUND;	ARCH BDD	ARCHITECT/ARCHITECTURAL BACKDRAFT DAMPER	MAX MBH	MAXIMUM 1000 BTU PER HOUR
	V			DOUBLE-LINE	ВНР	BRAKE HORSEPOWER	MCA	MINIMUM CIRCUIT AMPACITY
\ <u>\</u>		90° TAKEOFF WITH 45° ELONGATED TEE -		SUPPLY AIR DUCT IN CROSS-SECTION ROUTED UP OR HORIZONTAL MOUNTED SUPPLY AIR DIFFUSER	BLDG	BUILDING	MCC	MOTOR CONTROL CENTER
		ROUND TO ROUND		RETURN AIR DUCT IN CROSS-SECTION ROUTED UP OR	BTUH	BRITISH THERMAL UNITS PER HOUR	MECH	MECHANICAL
				HORIZONTAL MOUNTED RETURN AIR GRILLE	CA CFM	COMBUSTION AIR CUBIC FEET PER MINUTE	MFR MIN	MANUFACTURER MINIMUM
<u></u>				EXHAUST AIR DUCT IN CROSS-SECTION ROUTED UP OR	CIRC	CIRCULATING	MOCP	MAXIMUM OVERCURRENT PROTECTION
		90° CONICAL TEE - ROUND TO ROUND OR OVAL TO OVAL		HORIZONTAL MOUNTED EXHAUST AIR GRILLE	CLG	CEILING	(N)	NEW
$\int_{\infty}$				SUPPLY AIR DUCT IN CROSS-SECTION ROUTED DOWN	CONN	CONNECTION	NC	NORMALLY CLOSED
>				DETUDN AID DUCT IN CDOCC CECTION DOLLTED DOWN	CONT	CONTINUED, CONTINUATION	NIC	NOT TO SCALE
		Y BRANCH -		RETURN AIR DUCT IN CROSS-SECTION ROUTED DOWN	COOL	COOLING COORDINATE	NTS OA	NOT TO SCALE OUTSIDE AIR
, \		ROUND OR OVAL DUCT		EXHAUST AIR DUCT IN CROSS-SECTION ROUTED DOWN	СОР	COEFFICIENT OF PERFORMANCE	OBD	OPPOSED BLADE DAMPER
<i>y</i>	v		T M		CONST	CONSTRUCTION	ОС	ON CENTER
		90° ELBOW - RECTANGULAR DUCT	99	ROUND DUCT UP - SUPPLY, RETURN OR EXHAUST	CV	COEFFICIENT OF FLOW	OD	OUTSIDE DIAMETER
		(NO DUCT TURNING VANES)	10	ROUND DUCT DOWN - SUPPLY, RETURN OR EXHAUST	dBA DB	A-WEIGHTED DECIBELS  DRY BULB	PD PH	PRESSURE DROP PHASE
Jh	<u></u>			ROOND DOCT DOWN SOLLEY, RELOUND ON EXHAUST	DN	DOWN	P/N	PART NUMBER
<u> </u>		00° FLDOW DECTANCIII AD DUCT		VERTICAL MOUNTED SUPPLY AIR DEVICE	DSD	DUCT SMOKE DETECTOR	POC	POINT OF CONNECTION
		90° ELBOW -RECTANGULAR DUCT WITH TURNING VANES	,   ,		DWGS	DRAWINGS	PSI	POUNDS PER SQUARE INCH
<u></u>	$\bot$ $\bot$ $\bot$		<b>—</b>	VERTICAL MOUNTED RETURN OR EXHAUST AIR DEVICE	(E)	EXISTING TO REMAIN	P/T	PRESSURE/TEMPERATURE
$\hookrightarrow$	J—————————————————————————————————————	90° TAKEOFF WITH 45° TAPER -		AIR FROM DEVICE	EA EAT	EXHAUST AIR ENTERING AIR TEMPERATURE	QTY (R)	QUANTITY RELOCATE EXISTING
		RECTANGULAR TO RECTANGULAR (FOR BRANCH TAKEOFF LONGER THAN			EER	ENERGY EFFICIENCY RATIO	RA	RETURN AIR
		50'-0", USE 15°)	<b>—</b>	AIR TO DEVICE	EF	EXHAUST FAN	REQD	REQUIRED
Ť	v T√T				EFF	EFFICIENCY	RLA	RATED/RUNNING LOAD AMPS
		90° RADIUS SPLIT - RECTANGULAR DUCT, PROVIDE SPLITTER		BALANCE DAMPER	ELEC EQUIP	ELECTRICAL EQUIPMENT	RPM SA	REVOLUTIONS PER MINUTE SUPPLY AIR
)		DAMPER, X/Y PROPORTIONAL SPLIT	M	MOTORIZED DAMPER	ESP	EXTERNAL STATIC PRESSURE	SC	SENSIBLE COOLING
Ţ	±\± →\+				EWB	ENTERING WET BULB	SEER	SEASONAL ENERGY EFFICIENCY RATIO
	V	90° RECTANGULAR SPLIT -	—— <b>◆</b> FD	FIRE DAMPER - HORIZONTAL	EWT	ENTERING WATER TEMPERATURE	SF	SUPPLY FAN OR SQUARE FEET
<del>\</del>		RECTANGULAR DUCT, PROVIDE SPLITTER DAMPER, X/Y PROPORTIONAL SPLIT		FIRE DAMPER - VERTICAL	FD FSD	FIRE DAMPER FIRE AND SMOKE DAMPER	sov soo	SHUT-OFF VALVE SEQUENCE OF OPERATION
Ţ	$\perp \sqrt{\perp}$		FD	FIRE DAIVIFER - VERTICAL	FLA	FULL LOAD AMPS	SP	STATIC PRESSURE
		SPIN-IN WITH BALANCE DAMPER -		FIRE AND SMOKE DAMPER - HORIZONTAL	FLEX	FLEXIBLE	SPEC	SPECIFICATION
		RECTANGULAR TO ROUND OR RECTANGULAR TO OVAL	FSD		FPM	FEET PER MINUTE	TC	TOTAL (COOLING) CAPACITY
			FSD	FIRE AND SMOKE DAMPER - VERTICAL	FT FT HD	FEET FEET HEAD	TEMP TSP	TEMPERATURE TOTAL STATIC PRESSURE
	0.1.0.0	\\\\\\\\\\\\\\\\\\\\\\\\\\\\\\\\\\\\\\	(T)	THERMOSTAT	FTR	FLUE THRU ROOF	TSTAT	THERMOSTAT
	GAS S	<u>YMBOLS</u>			G	GAS	TYP	TYPICAL
SYMBOL		IDENTIFICATION	(S)	TEMPERATURE SENSOR	GA	GAUGE	UCD	UNDERCUT DOOR
	PIPE ABOVE GRA	.DF	CO <sub>2</sub>	CARBON DIOXIDE SENSOR	GPM	GALLONS PER MINUTE	UL	UNDERWRITER'S LABORATORIES
	PIPE BELOW GRA			CARBON DIOXIDE SENSOR	GPR HP	GAS PRESSURE REGULATOR HORSEPOWER	UON V	UNLESS OTHERWISE NOTED  VOLT
	PIPE UP		lacksquare	POINT OF CONNECTION	HR	HOUR	W/	WITH
	PIPE DROP		12x12		HSPF	HEATING SEASONAL PERFORMANCE	W	WATTS
<del></del>	PIPE DROP AT TE	EE	<u>CD - X</u>	REGISTER NECK SIZE AND MARK (DESIGN CFM)		FACTOR	WB	WET BULB
	PIPE CAP		(300)		HTG HZ	HEATING HERTZ	WC WT	WATER COLUMN WEIGHT
	PIPE TRANSITION		Ę.	CENTERLINE			(X)	EXISTING TO BE REMOVED
Н	TEE			CHEET VEVA OTE TA O				
$\overline{\bowtie}$	SHUT-OFF VALV	≣		SHEET KEYNOTE TAG		I F C F N I F	) NIO	ГГС
K	GAS PRESSURE F	EGULATOR		CONTRACTOR EQUIPMENT TAG		<u>LEGENI</u>	טאו כ	<u>  [2</u>
5	BALL VALVE				A. B.	ALL SYMBOLS MAY NOT BE USED IN THIS PROJECT SYMBOLS DO NOT ALWAYS REPRESENT REAL LIFE		
	UNION				C.	SEE BOOK SPECIFICATIONS FOR ADDITIONAL INF		
					D.	SEE PLANS FOR DUCT AND PIPE SIZES.		

# GENERAL MECHANICAL NOTES

- SCOPE OF WORK: THIS PROJECT IS NEW CONSTRUCTION. THE PLANS AND SPECIFICATIONS INDICATE THE GENERAL EXTENT OF THE WORK BASED ON OWNER PROVIDED INFORMATION AND LIMITED FIELD VERIFICATION. CONTRACTOR SHALL VISIT SITE, AND REPORT ANY DISCREPANCIES NOTED TO THE ENGINEER PRIOR TO SUBMITTING A BID. CONTRACTOR SHALL BE RESPONSIBLE FOR THE MECHANICAL, PLUMBING, AND ELECTRICAL SYSTEMS NECESSARY TO ACCOMPLISH THE WORK WHETHER OR NOT SPECIFIED AND/OR INDICATED.
- MECHANICAL CONTRACTOR SHALL NOTIFY GENERAL CONTRACTOR TO REPAIR WALL, FLOOR AND CEILING SURFACES AS REQUIRED DUE TO DEMOLITION OR INSTALLATION WORK.
- ALL CONTROL WIRING SHALL BE IN CONDUIT. CONDUIT AND WIRING SHALL BE PROVIDED AND INSTALLED BY THE MECHANICAL CONTRACTOR. PROVIDE AND INSTALL RIGID CONDUIT IN AREAS EXPOSED TO THE ELEMENTS.
- ALL TRANSITIONS IN DUCTWORK SHALL BE MADE AT 15 DEGREES TO EACH FACE MAXIMUM, UNLESS OTHERWISE NOTED OR SPECIFICALLY
- MECHANICAL CONTRACTOR TO REVIEW TRUSS SUBMITTAL PRIOR TO DUCT FABRICATION AND VERIFY TRUSS OPENING SIZES AND DUCT SIZES

# LIST OF GOVERNING CODES

THIS WORK SHALL CONFORM TO ALL CURRENT AND ADOPTED LOCAL CODES

- OREGON STRUCTURAL SPECIALTY CODE (OSSC)
- OREGON MECHANICAL SPECIALTY CODE (OMSC)
- OREGON PLUMBING SPECIALTY CODE (OPSC)
- OREGON ENERGY CODE (OEG)
- OREGON FIRE CODE (OFC)

# **COMMISSIONING MECHANICAL**

MECHANICAL SYSTEM COMMISSIONING STATEMENT OF WORK: MECHANICAL SYSTEM COMMISSIONING SHALL BE PROVIDED IN ACCORDANCE WITH THE REQUIREMENTS OF THE 2025 OREGON ENERGY CODE (OEESC). A THIRD PARTY COMMISSIONING AGENT (CXA) WILL BE CONTRACTED BY THE OWNER TO VERIFY SYSTEM PERFORMANCE IN ACCORDANCE WITH OEESC REQUIREMENTS. THE CXA WILL PROVIDE THE COMMISSIONING PLAN AND TEST RESULTS. FUNCTIONAL TESTING WILL BE REQUIRED FOR NEW HVAC SYSTEMS.

	MECHANICAL SHEET KEY	
SHEET NUMBER	DESCRIPTION	
M001	LEGEND	
M002	SCHEDULES	
M003	SCHEDULES	
M201	FIRST FLOOR - HVAC	
M202	MECHANICAL - MEZZANINE	
M211	FIRST FLOOR - SECTOR A - HVAC	
M212	FIRST FLOOR - SECTOR B - HVAC	
M213	MEZZANINE - SECTOR A - HVAC	
M214	MEZZANINE - SECTOR B - HVAC	
M231	ROOF - HVAC	
M301	FIRST FLOOR - HYDRONIC	
M302	FIRST FLOOR - SNOWMELT	
M311	FIRST FLOOR - SECTOR A - HYDRONIC	
M312	FIRST FLOOR - SECTOR B - HYDRONIC	
M320	ENLARGED PLANS	
M401	FIRST FLOOR - GAS	
M501	HOT WATER PIPING DIAGRAMS	
M502	CHILLED WATER PIPING DIAGRAMS	
M601	CONTROLS	
M701	HVAC DETAILS	
M702	HVAC & PIPING DETAILS	
M703	SNOWMELT DETAILS	1







SHEET TITLE: **LEGEND** 

REVISIONS: # DESCRP.

ISSUE DATE: 08/26/2025

EXPIRES 06/30/2027

ISSUE DATE: 08/26/2025

### **FAN COIL UNITS FAN MOTORS** ELECTRICAL SERVING **MAKE & MODEL** NOTES MARK (LBS) WPD (FT. WC) ROWS V/PH MCA MOCP SCCR FLOW (GPM) WPD (FT. WC) ROWS TH (MBH) EAT DB (F) LAT DB (F) EWT (F) CFM RPM TC (MBH) SC (MBH) EAT DB (F) LAT DB (F) EWT (F) 1000 2 0.23 1/3 1008 21.5 15.9 75 57.8 3.4 0.48 100 2 | 208/1 | 6.75 | 15 | 15 | 254 JCI FNP16 ALL Classroom 135 29.6 65 95.1 1.9 FC-101 0.23 75 57.8 3.4 95.1 130 100 1.9 0.17 2 | 208/1 | 6.75 | 15 | 15 | 254 JCI FNP16 ALL Classroom 137 57.8 JCI FNP16 ALL Classroom 140 2 0.23 1/3 3.4 0.48 29.6 130 100 1.9 0.17 2 | 208/1 | 6.75 | 15 | 15 | 254 FC-103 57.8 3.4 0.48 100 1.9 0.17 2 | 208/1 | 6.75 | 15 | 15 | 254 JCI FNP16 ALL Classroom 142 1000 0.4 2 | 0.23 | 1/3 | 1008 21.5 15.9 75 29.6 95.1 130 65 FC-104 15.9 57.8 Classroom 132 2 0.23 1/3 21.5 75 3.4 0.48 29.6 95.1 130 100 1.9 0.17 2 | 208/1 | 6.75 | 15 | 15 | 254 JCI FNP16 ALL FC-105 1/3 15.9 57.8 29.6 100 2 | 208/1 | 6.75 | 15 | 15 | 254 JCI FNP16 Classroom 130 1000 450 0.4 2 0.23 1008 21.5 75 60 3.4 0.48 65 95.1 130 1.9 0.17 ALL 0.4 2 0.23 1/3 1008 15.9 57.8 3.4 0.48 100 1.9 0.17 2 | 208/1 | 6.75 | 15 | 15 | 254 JCI FNP16 ALL Classroom 127 1000 21.5 75 29.6 95.1 130 65 FC-107 57.8 Classroom 125 2 0.23 1/3 21.5 15.9 75 60 3.4 0.48 29.6 95.1 130 100 1.9 0.17 2 | 208/1 | 6.75 | 15 | 15 | 254 JCI FNP16 ALL FC-108 56.1 55.5 2.20 JCI FNP14 ALL Office Area 0.5 2 0.3 1/3 1235 36.8 75 1.38 33.3 130 100 0.21 2 | 208/1 | 6.75 | 15 | 15 | 193 FC-109 Classroom 157 0.4 1 0.3 1/3 1204 14.2 10.8 75 58.3 2.30 1.02 20.6 65 95.2 130 100 1.3 0.35 2 | 208/1 | 3.75 | 15 | 15 | 166 JCI FNP10 ALL FC-201 Break 172/Office 201 0.3 1/3 14.8 75 58.0 2.50 1.23 130 100 0.90 2 | 208/1 | 3.75 | 15 | 15 | 166 JCI FNP10 ALL 100 JCI FNP16 Large Conf 208 1/3 21.7 58.6 3.2 0.43 31.7 130 2.00 2 | 208/1 | 6.75 | 15 | 15 | 242 ALL 2 | 0.3 75 FC-203 Entry / Commons 0.5 2 0.5 36.2 75 58.8 61.1 5.10 1.95 65 91.5 130 100 3.90 1.43 2 | 208/1 | 16.43 | 20 | 20 | 527 JCI AHD30 ALL FC-204 0.4 2 0.23 1/3 15.5 58.2 2 | 208/1 | 6.75 | 15 | 15 | 254 1000 1008 20.6 75 61.1 3.1 0.41 29.6 95.1 130 100 1.9 0.17 JCI FNP16 ALL Classroom 159 65 FC-206 2 | 208/1 | 6.75 | 15 | 15 | 254 KCC CR 205 58.2 100 JCI FNP16 ALL 0.4 2 0.23 1/3 1008 20.6 15.5 75 61.1 3.1 0.41 29.6 95.1 130 1.9 0.17 65 KCC CR 204 1000 0.4 2 0.23 1/3 1008 20.6 15.5 75 3.1 0.41 29.6 65 95.1 130 100 1.9 0.17 2 | 208/1 | 6.75 | 15 | 15 | 254 JCI FNP16 ALL FC-208 0.4 2 0.23 1/3 58.2 1000 455 1008 20.6 15.5 75 61.1 3.1 29.6 95.1 130 100 1.9 0.17 2 | 208/1 | 6.75 | 15 | 15 | 254 JCI FNP16 Classroom 164 0.41 65 ALL

### NOTES:

1. PROVIDE BELIMO ACTUATORS ON ALL CONTROL VALVES. ACTUATORS PROVIDED BY CONTROLS CONTRACTOR AND INSTALLED BY MECHANICAL CONTRACTOR. REFER TO DRAWINGS FOR COIL HANDLING.

20.6

15.5

75

58.2

61.1

3.1

0.40

2. STAINLESS STEEL DRAIN PAN WITH FACTORY MOUNTED OVERFLOW SWITCH, PROVIDE CONDENSATE PUMP.

1000

3. SEE VENTILATION REQUIREMENTS SCHEDULE FOR OA AIRFLOW REQUIREMENTS. BALANCE OA AIRFLOWS AS NOTED.

455 0.4 2 0.23 1/3 1008

4. SEE M701 FOR CONNECTION AND MOUNTING DETAILS.

Classroom 161

- 5. PROVIDE ECM MOTORS
- 6. PROVIDE WITH 2 WAY CONTROL VALVES ON EACH COIL SEE DETAIL
- 7. PROVIDE WITH 2" MERV 13 FILTERS

																		DE	DICA	TED C	UTD	OOR	AIR	R SYSTE	M																					
					SUPP	LY FAN					EXHA	UST FAI	N														Н	IEATING V	ATER CC	DIL					(	HILLED V	VATER CO	OIL			F	LECTRICA	AL			
			AUDEL OVA	FCD		N	<b>MOTOR</b>		415	NEI 014	FCD		мотоі	R		WIN	TER (HE	ATING)			SUN	MER (CO	OLING)	)						51.004		TD DD	TOTAL					FI 0)44		\\(\tau_{\\ \tau_{\tau_{\tau_{\\ \tau_{\tau_{\\ \tau_{\\ \\ \tau_{\\ \tau_{\\ \\ \\ \\ \\ \\ \\ \\ \\ \\ \\ \\ \\						
MARK	LOCATION	SERVING	AIRFLOW CFM	IN WG	ВНР	НР	RPM	CONTR		RFLOW CFM	ESP IN WG	ВНР	НР	RPM	OSA EAT	OSA LAT	EA EAT	EA LAT	TOT EFF. 9	OSA EAT	OSA LAT	EA EAT	EA LAT	T TOT EFF. %	HEAT MBH	EAT	LAT	EWT	LWT	FLOW GPM	ROWS	WTR PD FT	MBH	EAT	LAT	EWT	LWT	FLOW GPM		WTR PD	V/PH	MCA	МОСР	WT LBS	MAKE 8	& MODEL
DOAS-1	RR 136 MEZZ	SECTOR A - WEST	2300	2.40	1.27	2	1777	ECM	1 2	2300	1.37	0.7	4	1216	10	53	70	28.3	68.7	91	79.3	75	86.6	70.4	88.4	53	92.7	130	110	9	2	0.7	83.2	79.3	56.6	46	50.9	11	6	4.2	208/3	16	20	1875	AAC	ON V3
DOAS-2	RR 160 MEZZ	SECTOR B - NORTH	1290	2.28	0.85	1	2015	ECM	1	1290	1.24	0.37	1.34	1769	10	53	70	27	71.2	91	79.2	75	86.7	72	43.6	53.3	88.3	130	110	3	2	1.2	47.7	79.2	55.1	46	53.8	8.5	6	5.2	208/3	6	15	1556	AAC	ON V3
DOAS-3	RR 133 MEZZ	SECTOR A - EAST	2215	2.40	1.21	2	1748	ECM	1 2	2215	1.34	0.66	4	1195	10	53	70	28.1	69.1	91	79.2	75	86.6	70.7	82.5	54	80	130	110	5.5	2	2.1	82.5	79.2	55.0	46	55.6	12	6	6.2	208/3	16	20	1875	AAC	ON V3
DOAS-4	RR 162 MEZZ	SECTOR B - SOUTH	1830	3.73	1.65	2	2511	ECM	1	1830	1.5	0.69	1	2222	10	53	70	29.1	67.1	91	79.2	75	86.5	69.4	48	54	80	130	110	4	2	2	62.0	79.2	58.9	46	53.0	12	6	7.9	208/3	9	15	1556	AAC	ON V3

29.6

65

95.1

- 1. SUPPLY FANS AND EXHAUST FANS SHALL BE PROVIDED WITH EC MOTORS.
- 2. 100% OSA UNIT WITH STATIC PLATE ENERGY RECOVERY.
- 3. UNIT MOUNTED ON MEZZANINE. REFERENCE STRUCTURAL DOCUMENTS FOR ANCHORAGE REQUIREMENTS.
- 4. PROVIDE DUCT SMOKE DETECTORS IN SUPPLY AIR AND EXHAUST AIR DUCTWORK. INTERLOCK DETECTORS WITH ELECTRICAL SERVICE TO DE-ENERGIZE UNIT UPON DETECTION OF SMOKE.
- 5. PROVIDE WITH MOTORIZED DAMPERS ON OA AND EA. ACTUATORS BY CONTROLS CONTRACTOR.

	Junium (1997)
AIR COOLED CHILLER	

													<b></b>										
			EVAPOR	RATOR - OPERAT	ING CONDITION		cc	ONDENSE	R FANS	COMPR	ESSORS		ELECT	RICAL						REFRIGERANT	WT		
MARK	TONS	EWT (F)	LWT (F)	MIN. FLOW (GPM)	DESIGN FLOW (GPM)	WPD (FT. WC)	OADB (F)	QTY	FLA (EACH)	TYPE	QTY	V/PH	MCA	МОСР	SCCR	EER	IPLV	GLYCOL (%)	REFRIGERANT	CHARGE (LBS)	(LBS)	MAKE & MODEL	NOTES
<u>CH-1</u>	50	61	46	48	83.86	8	91	2	7.6	SCROLL	4	208/3	235	250	250	11.8	18	30	R454B	66	3503	YORK YLAA0048J17XCB	ALL

- 1. SOUND PRESSURE: 94 DBA OVERALL. SOUND POWER: 93 DBA OVERALL.
- 2. PROVIDE COMPRESSOR SOUND BLANKETS.
- 3. SINGLE POINT POWER CONNECTION AND DISCONNECT. PHASE AND UNDER/OVER VOLTAGE PROTECTION.
- 4. INSTALL ON XXX (CONCRETE PAD) . SEE X/M701 FOR DETAILS.
- 5. SEE 1/M502 FOR PIPING DIAGRAM. HEAT TRACE EXTERIOR PIPES.

							HOT	WA1	TER CO	NDEN	ISING	<b>BOILI</b>	ER
LOCATION	INPUT	HIGH FIRE	AFUE	MIN GAS PRESS	MAX GAS PRESS	TURNDOWN	MAX GPM	MIN GPM	MAX PD	EWT [°F]	LWT [°F]	MAX PRESS	FLU

								1101				421140	DOIL	LIX								
MARK	LOCATION	INPUT [MBH]	HIGH FIRE OUTPUT [MBH]	AFUE [%]	MIN GAS PRESS [IN. WC]	MAX GAS PRESS [IN. WC]	TURNDOWN	MAX GPM	MIN GPM	MAX PD [PSIG]	EWT [°F]	LWT [°F]	MAX PRESS [PSIG]	FLUE DIAM [IN]		GAS INLET	ELEC [V/H/P]	FLA	MANUFACTURER	MODEL	OPER WEIGHT [LBS]	NOTES
B-1	<b>BOILER RM</b>	600	585	97.5	5	14	7:1	105	10	160	110	130	160	4	4	1	120/1	6	LOCHINVAR	FTX600	560	1, 2, 3, 4, 5, 6, 7
B-2	<b>BOILER RM</b>	600	585	97.5	5	14	7:1	105	10	160	110	130	160	4	4	1	120/1	6	LOCHINVAR	FTX600	560	1, 2, 3, 4, 5, 6, 7

- 1. PROVIDE ONE ANSI CERTIFIED GAS REGULATOR WITH EACH BOILER. CONTRACTOR TO VENT REGULATOR OUTDOORS.
- 2. PROVIDE MANUFACTURER'S CONDENSATE NEUTRALIZER. ONE PER BOILER.
- 3. PROVIDE MANUFACTURER'S CONCENTRIC VENT KIT. ONE PER BOILER.
- 4. PROVIDE 6" CONCRETE SERVICE PAD.
- 5. PROVIDE WITH BACNET MSTP OPTION FOR INTEGRATION INTO BAS. PROVIDE WITH FLOW SWITCH.
- 6. PROVIDE HIGH ALTITUDE OPTION IF REQUIRED
- 7. SEE M501 FOR PIPING DIAGRAM

7. SEE IV	71501 FOR PIPING DIAGRAM											
			\\\\\\\\\\\\\\\\\\\\\\\\\\\\\\\\\\\\\\	~~~	<b>***</b>	\\\\\\\\\\\\\\\\\\\\\\\\\\\\\\\\\\\\\\		****	~~~			\
_					EXI	HAU	ST FANS					ADD
MARK	SERVING	CFM	ESP	SONES		МС	TOR	FAN	WT	MAKE & MODEL	NOTES	
IVIAKK	SERVING	CFIVI	ESP	SUNES	V/PH	AMPS	WATTS/HP	RPM	LBS	MAKE & MODEL	NOTES	$\mathbb{R}^{2}$
<u>KEF-1</u>	KITCHEN GREASE HOOD	2150	1.0	11.5	208/3	4.4	1.5	1073	162	CAPTIVEAIRE DU180HFA	1, 2, 3	
OTES:	-		•		•	•		'			'	K

- 1. CONTRACTOR IS RESPONSIBLE FOR PROVIDING A COMPLETE CONTROLS SYSTEM IN ORDER TO ACCOMPLISH THE DESCRIPTION OF CONTROLS DESCRIBED IN SCHEDULE AND IN
- MAU SEQUENCE OF OPERATION.
- 2. INTERLOCK HOOD FAN OPERATION W/ MAU-1 FOR BALANCED VENTILATION.
- 3. REFER TO SHEETS FROM MFR FOR INSTALLATION REQUIREMENTS.

100

1.9

0.17

130

2 | 208/1 | 6.75 | 15 | 15 | 254

JCI FNP16

ALL

PRINTED ON: 8/28/2023 3:19:28 PM FROM FILE: Autode
--

							I	HYDRO	ONIC F	PUMP	S						
A A A DIV	CEDVICE	LOCATION	TVDE	FLOW	HEAD	DUTY EFF	NPSH	OPER.			МО	TOR			WT	MAKE & MODEL	NOTES
MARK	SERVICE	LOCATION	TYPE	GPM	FT	%	FT	RPM	ВНР	НР	RPM	V/PH	CONTROL	TYPE	LBS	MAKE & MODEL	NOTES
<u>CHP-1</u>	CHILLED WATER	BOILER ROOM	VERT. IN-LINE	106	55	58.2	5.8	1893	2.6	3	2000	208/3	VFD	TEFC	185	BG E-80X 2X7B	1,2
CHP-2	CHILLED WATER	BOILER ROOM	VERT. IN-LINE	106	55	58.2	5.8	1893	2.6	3	2000	208/3	VFD	TEFC	185	BG E-80X 2X7B	1,2
<u>BP-1</u>	PRIMARY HW	BOILER ROOM	CIRC. IN-LINE	50	12	56.4	-	2576	-	0.5	-	208/1	ECM	-	35	BG ECOCIRC XL 20-140	2
<u>BP-2</u>	PRIMARY HW	BOILER ROOM	CIRC. IN-LINE	50	12	56.4	-	2576	-	0.5	-	208/1	ECM	-	35	BG ECOCIRC XL 20-140	2
HWP-1	SECONDARY HW	BOILER ROOM	VERT. IN-LINE	116	40	32.8	4.7	1681	1.8	3	2000	208/3	VFD	TEFC	215	BG E-80X 2.5X7B	1,2
HWP-2	SECONDARY HW	BOILER ROOM	VERT. IN-LINE	116	40	62.8	4.7	1681	1.8	3	2000	208/3	VFD	TEFC	215	BG E-80X 2.5X7B	1,2
<u>SP-1</u>	SNOWMELT	BOILER ROOM	CIRC. IN-LINE	17	20	45.8	-	3417	-	0.167	-	115/1	ECM	-	16	BG ECOCIRC XL 36-45	1,2
SP-2	SNOWMELT	BOILER ROOM	CIRC. IN-LINE	17	20	45.8	-	3417	-	0.167	-	115/5	ECM	-	16	BG ECOCIRC XL 36-45	1,2

A. EFFICIENCY LISTED IS WIRE TO WATER EFFICIENCY.

B. CHILLED WATER SYSTEM IS 40% PROPYLENE GLYCOL. HOT WATER SYSTEM IS WATER ONLY.

PROVIDE WITH INVERTER DUTY MOTOR AND INTEGRATED VFD.

										SPLIT	SYSTEM F	IEAT PU	MPS				
. [	NAADIK	CEDVINC	COOL	МВН	HEAT	CENA	ELEC	TRICAL [	DATA		REFRIGERANT DA	TA	CEEDS	LICDES	WT	MAKE & MODEL	NOTES
-	MARK	SERVING	TC	sc	MBH	CFM	V/PH	MCA	МОСР	ТҮРЕ	LINE LENGTH	CHARGE (LBS)	SEER2	HSPF2	LBS	MAKE & MODEL	NOTES
-	<u>HP-01</u>	MDF	30	22	30	-	208/1	19	30	R-32	168 FT	4.081	22	9.7	135.4	LG-KUSAP241A	6
-	<u>FC-01</u>	WIDF	30	22	30	389	-		=	-		-	-	-	36.6	LG-KNSAP241A	1,2,3,4,5
	<u>HP-02</u>	MDF	14	12	12	-	208/1	12	15	R-32	82 FT	1.81	22.5	10.5	68.8	LG - KSUAB121A	6
-	<u>FC-02</u>	WIDF	14	12	12	194	-		-	-		-	-	-	19.73	LG - KNUAB121A	1,2,3,4,5

- 1. PROVIDE PROGRAMMABLE THERMOSTAT & CONDENSATE PUMP. ROUTE CONDENSATE TO NEAREST APPROVED RECEPTACLE.
- 2. CONTROLS CONTRACTOR SHALL FURNISH AND INSTALL REMOTE TEMPERATURE SENSOR AND CONNECT TO DDC SYSTEM FOR MONITORING. GENERATE ALARM ON TEMPERATURE RISE ABOVE SETPOINT.
- 3. SIZE AND INSTALL REFRIGERANT LINES PER MANUFACTURER'S RECOMMENDATIONS.
- 4. PROVIDE WITH MANUFACTURERS FACTORY MOUNTED REFRIGERANT LEAK DETECTOR.
- INDOOR UNIT POWERED BY OUTDOOR UNIT.

1. SEE CAPTIAVEAIRE DRAWINGS FOR MOUTING AND INSTALLATION

2. PROVIDE WITH BUILT-IN THERMOSTAT AND SET NO HIGHER THAN 60 DEG F.

6. MOUNT OUTDOOR UNIT ON QSMS1200 MINI SPLIT STAND AND ANCHOR TO HOUSEKEEPING PAD.

								N	ЛАКЕ	UP	AIR	UNIT	ΓS					
MARK	CEDVING	COOL	. МВН	HEAT	г мвн	TONS	CFM	ECD	FAN	МС	OTOR	UI	NIT	WT	SEER	HEAT	MAKE & MODEL	NOTEC
IVIARK	SERVING	TC	sc	IN	OUT	TONS	CFIVI	ESP	RPM	НР	V/PH	MCA	МОСР	LBS	SEER	EFF.	WAKE & WODEL	NOTES
MAU-1	KITCHEN	91	90	174	141	7.5	2150	0.5	2175	1.5	208/3	33.9	35	726	18.6	92%	CAPTIVEAIRE CAS-HVAC1-I.200-18-7.5T	1
NOTES:		•	•		•	•			•		•							

kummummummummummummummummummum

		Н	<b>YDRO</b>	NIC AC	CESSORIES	
MARK	DESCRIPTION	SERVING	CONN SIZE	WEIGHT	MAKE AND MODEL	REMARKS
AS-1	AIR SEPARATOR	CHILLED WATER	3	85	TACO 4903AD-125	3 INCH AIR AND DIRT INLINE COALESCING SEPARATOR
BT-1	BUFFER TANK	CHILLED WATER	3	280	TACO BTL0100F	3 INCH 100 GALLON BUFFER TANK. LOW CONNECTIONS
ET-1	EXPANSION TANK	CHILLED WATER	3/4	120	TACO CA90-125	23 GALLON TANK, BLADDER TYPE, FULL ACCEPTANCE
ET-2	EXPANSION TANK	HOT WATER	3/4	120	TACO CA90-125	23 GALLON TANK, BLADDER TYPE, FULL ACCEPTANCE
ET-3	EXPANSION TANK	SNOW MELT	3/4	120	TACO CA90-125	23 GALLON TANK, BLADDER TYPE, FULL ACCEPTANCE
GMU-1	GLYCOL MAKEUP UNIT	CHILLED WATER	-	18	AXIOM DMF300	17 GALLON TANK, 0-45 PSI PRESSURE, DIGITAL CONTROL
GMU-2	GLYCOL MAKEUP UNIT	SNOW MELT	-	18	AXIOM DMF300	17 GALLON TANK, 0-45 PSI PRESSURE, DIGITAL CONTROL
HS-1	HYDRAULIC SEPARATOR	HOT WATER	3	240	TACO 5903P-42	HYDRAULIC SEPARATOR WITH AIR AND DIRT SEPARATION
PF-1	POT FEEDER	CHILLED WATER	3/4	50	AXIOM CBF-5	5 GALLON CHEMICAL BYPASS FEEDER
PF-2	POT FEEDER	HOT WATER	3/4	50	AXIOM CBF-5	5 GALLON CHEMICAL BYPASS FEEDER

	AIR DISTRIBUTION										
MARK	ТҮРЕ	MAKE & MODEL	REMARKS ADD 4								
~~~~~	~~~~~~~	~~~~~~~~~~~~~~~~~~~~~~~~~~~~~~~~~~~~~~									
<u>LS-1</u>	SUPPLY	TITUS FL-10	PRICE LINEAR SLOT, 2 SLOTS, SUPPLY GRILLE, SURFACE MOUNTED, 1" SLOT, 4' LENGTH, FIELD PLENUM								
LR-1	RETURN	TITUS FL-10	PRICE LINEAR SLOT, 2 SLOTS, RETURN GRILLE, SURFACE MOUNTED, 1" SLOT, 5' LENGTH, FIELD PLENUM								
RG-1	RETURN	TITUS 50F	24X24 EGGCRATE FACE RETURN, MATCH FRAME TO CEILING TYPE, NECK SIZE AS INDICATED								
<u>RG-2</u>	RETURN	TITUS 350RL	LOUVERED FACE RETURN, SIZE AS INDICATED								
<u>SD-1</u>	SUPPLY	TITUS OMNI	24X24 PLAQUE DIFFUSER, MATCH FRAME TO CEILING TYPE, NECK SIZE AS INDICATED								
<u>SD-2</u>	SUPPLY	TITUS 300RL	DOUBLE DEFLECTION LOUVERED FACE SUPPLY, SIZE AS INDICATED								
<u>EG-1</u>	EXHAUST	TITUS 50F	24X24 EGGCRATE FACE RETURN, MATCH FRAME TO CEILING TYPE, NECK SIZE AS INDICATED								
<u>LV-1</u>	LOUVER	RUSKIN ELF6375DX	LOUVERED SUPPLY, SIZE AS INDICATED								
<u>LV-2</u>	LOUVER	RUSKIN ELF6375DX	LOUVERED EXHAUST, SIZE AS INDICATED								
NOTES: 1. MAY PR	OVIDE EQUIVALENT EQUIP	MENT FROM NAILOR, PRIC	CE, TUTTLE & BAILEY, GREENHECK.								

ELECTRIC HEATERS									
MARK	SERVING	CFM	кw	AMPS	V/PH	WT LBS	MAKE & MODEL	NOTES	
<u>EH-1</u>	BOILER 149	100	1.5	12.5	120/1	22	BERKO FRA1512F	1, 2	
<u>EH-2</u>	FIRE RISER 167	100	1.5	12.5	120/1	22	BERKO FRA1512F	1, 2	
EH-3	VESTIBULE 100	100	1.5	12.5	120/1	22	BERKO FRA1512F	1, 2	

TAG	ROOM	PEOPLE	@	CFM/PERSON	+	AREA	@	CFM/SQ.FT.	/	Ez	=	CFM OSA REQUIRED	CFM OSA PROVIDED
	CLASSROOM 135	24	@	10.0	+	957.0	@	0.12	/	0.8	=	442.6	450
	CLASSROOM 137	24	@	10.0	+	951.0	@	0.12	/	0.8	=	439.8	440
DOAS-1	CLASSROOM 140	24	@	10.0	+	948.0	@	0.12	/	0.8	=	438.5	440
-	CLASSROOM 140	24	@	10.0	+	950.0	@	0.12	/	0.8	=	439.4	440
=	COMMONS	50	@	5.0	+	2,800.0	@	0.06	/	0.8	=	522.5	530
,					<b>'</b>					DOAS-1	TOTAL:	2282.8	2300
	CLASSROOM 159	24	@	10.0	+	971.0	@	0.12	/	0.8	=	449.1	450
-	CLASSROOM 157	21	@	10.0	+	854.0	@	0.12	/	0.8	=	395.0	400
=	BREAK ROOM 172	10	@	5.0	+	382.0	@	0.06	/	0.8	=	88.3	90
-	SHARED OFFICE 201	4	@	5.0	+	227.0	@	0.06	/	0.8	=	42.0	45
DOAS-2	LARGE CONFERENCE 209	20	@	5.0	+	394.0	@	0.06	/	0.8	=	152.7	155
	OFFICE 208	1	@	5.0	+	100.0	@	0.06	/	0.8	=	10.6	15
	OFFICE 207	1	@	5.0	+	104.0	@	0.06	/	0.8	=	11.1	15
	HALLWAY 200	0	@	0.0	+	620.0	@	0.06	/	0.8	=	46.5	50
=	HALLWAY 105/106	0	@	0.0	+	908.0	@	0.06	/	0.8	=	68.1	70
,					<b>'</b>	1				DOAS-2	TOTAL:	1263.4	1290
	CLASSROOM 132	24	@	10.0	+	974.0	@	0.12	/	0.8	=	450.5	455
-	CLASSROOM 130	24	@	10.0	+	972.0	@	0.12	/	0.8	=	449.6	450
=	CLASSROOM 127	24	@	10.0	+	971.0	@	0.12	/	0.8	=	449.1	450
-	CLASSROOM 135	24	@	10.0	+	975.0	@	0.12	/	0.8	=	450.9	455
-	SHARED OFFICE 118	4	@	5.0	+	211.0	@	0.06	/	0.8	=	40.8	45
-	SHARED OFFICE 115	3	@	5.0	+	213.0	@	0.06	/	0.8	=	34.7	35
-	OFFICE 114	1	@	5.0	+	105.0	@	0.06	/	0.8	=	11.2	15
DOAS-3	OFFICE 113	1	@	5.0	+	104.0	@	0.06	/	0.8	=	11.1	15
-	RECEPTIONS 112	3	@	5.0	+	102.0	@	0.06	/	0.8	=	26.8	30
-	SHARED OFFICE 111	3	@	5.0	+	145.0	@	0.06	/	0.8	=	29.6	30
	DIRECTORS OFFICE 110	1	@	5.0	+	152.0	@	0.06	/	0.8	=	16.2	20
	SMALL CONF. 117	6	@	5.0	+	115.0	@	0.06	/	0.8	=	44.6	45
	OFFICE 119	1	@	5.0	+	120.0	@	0.06	/	0.8	=	12.8	15
	HALLWAY 103	0	@	0.0	+	1,464.0	@	0.06	/	0.8	=	109.8	110
	WORK AREA 120	2	@	5.0	+	419.0	@	0.06	/	0.8	=	44.5	45
										DOAS-3	TOTAL:	2182.0	2215
	CLASSROOM 161	25	@	10.0	+	982.0	@	0.12	/	0.8	=	454.2	455
	CLASSROOM 164	24	@	10.0	+	976.0	@	0.12	/	0.8	=	451.4	455
DOAS-4	LACTATION/QUIET 168	1	@	5.0	+	73.0	@	0.06	/	0.8	=	11.7	15
	KCC CR 205	24	@	10.0	+	965.0	@	0.12	/	0.8	=	446.3	450
	KCC CR 206	24	@	10.0	+	952.0	@	0.12	/	0.8	=	440.3	455
		1			1	1				DOAS-4	TOTAL	1803.9	1830

**VENTILATION REQUIREMENTS** 

					HEA	T EX	CHAN	GER					
			HOT SIDE				COLD SIDE						
MARK	LOCATION	FLOW (GPM)	INLET TEMP (ºF)		PRESSURE DROP (PSI)	_	INLET TEMP (ºF)	OUTLET TEMP (ºF)	PRESSURE DROP (PSI)		WEIGHT (LBS)	MAKE & MODEL	NOTES
HX-1	BOILER	15.8	130	100	1.188	17	85	115	2.282	8.33	182	TACO PF 09-35-1-NH	1

Commence and the commence of t








SHEET TITLE: SCHEDULES

REVI	SIONS:	
#	DESCRP.	DATE
1	ADD 4	08/29/20

ISSUE DATE: 08/26/2025

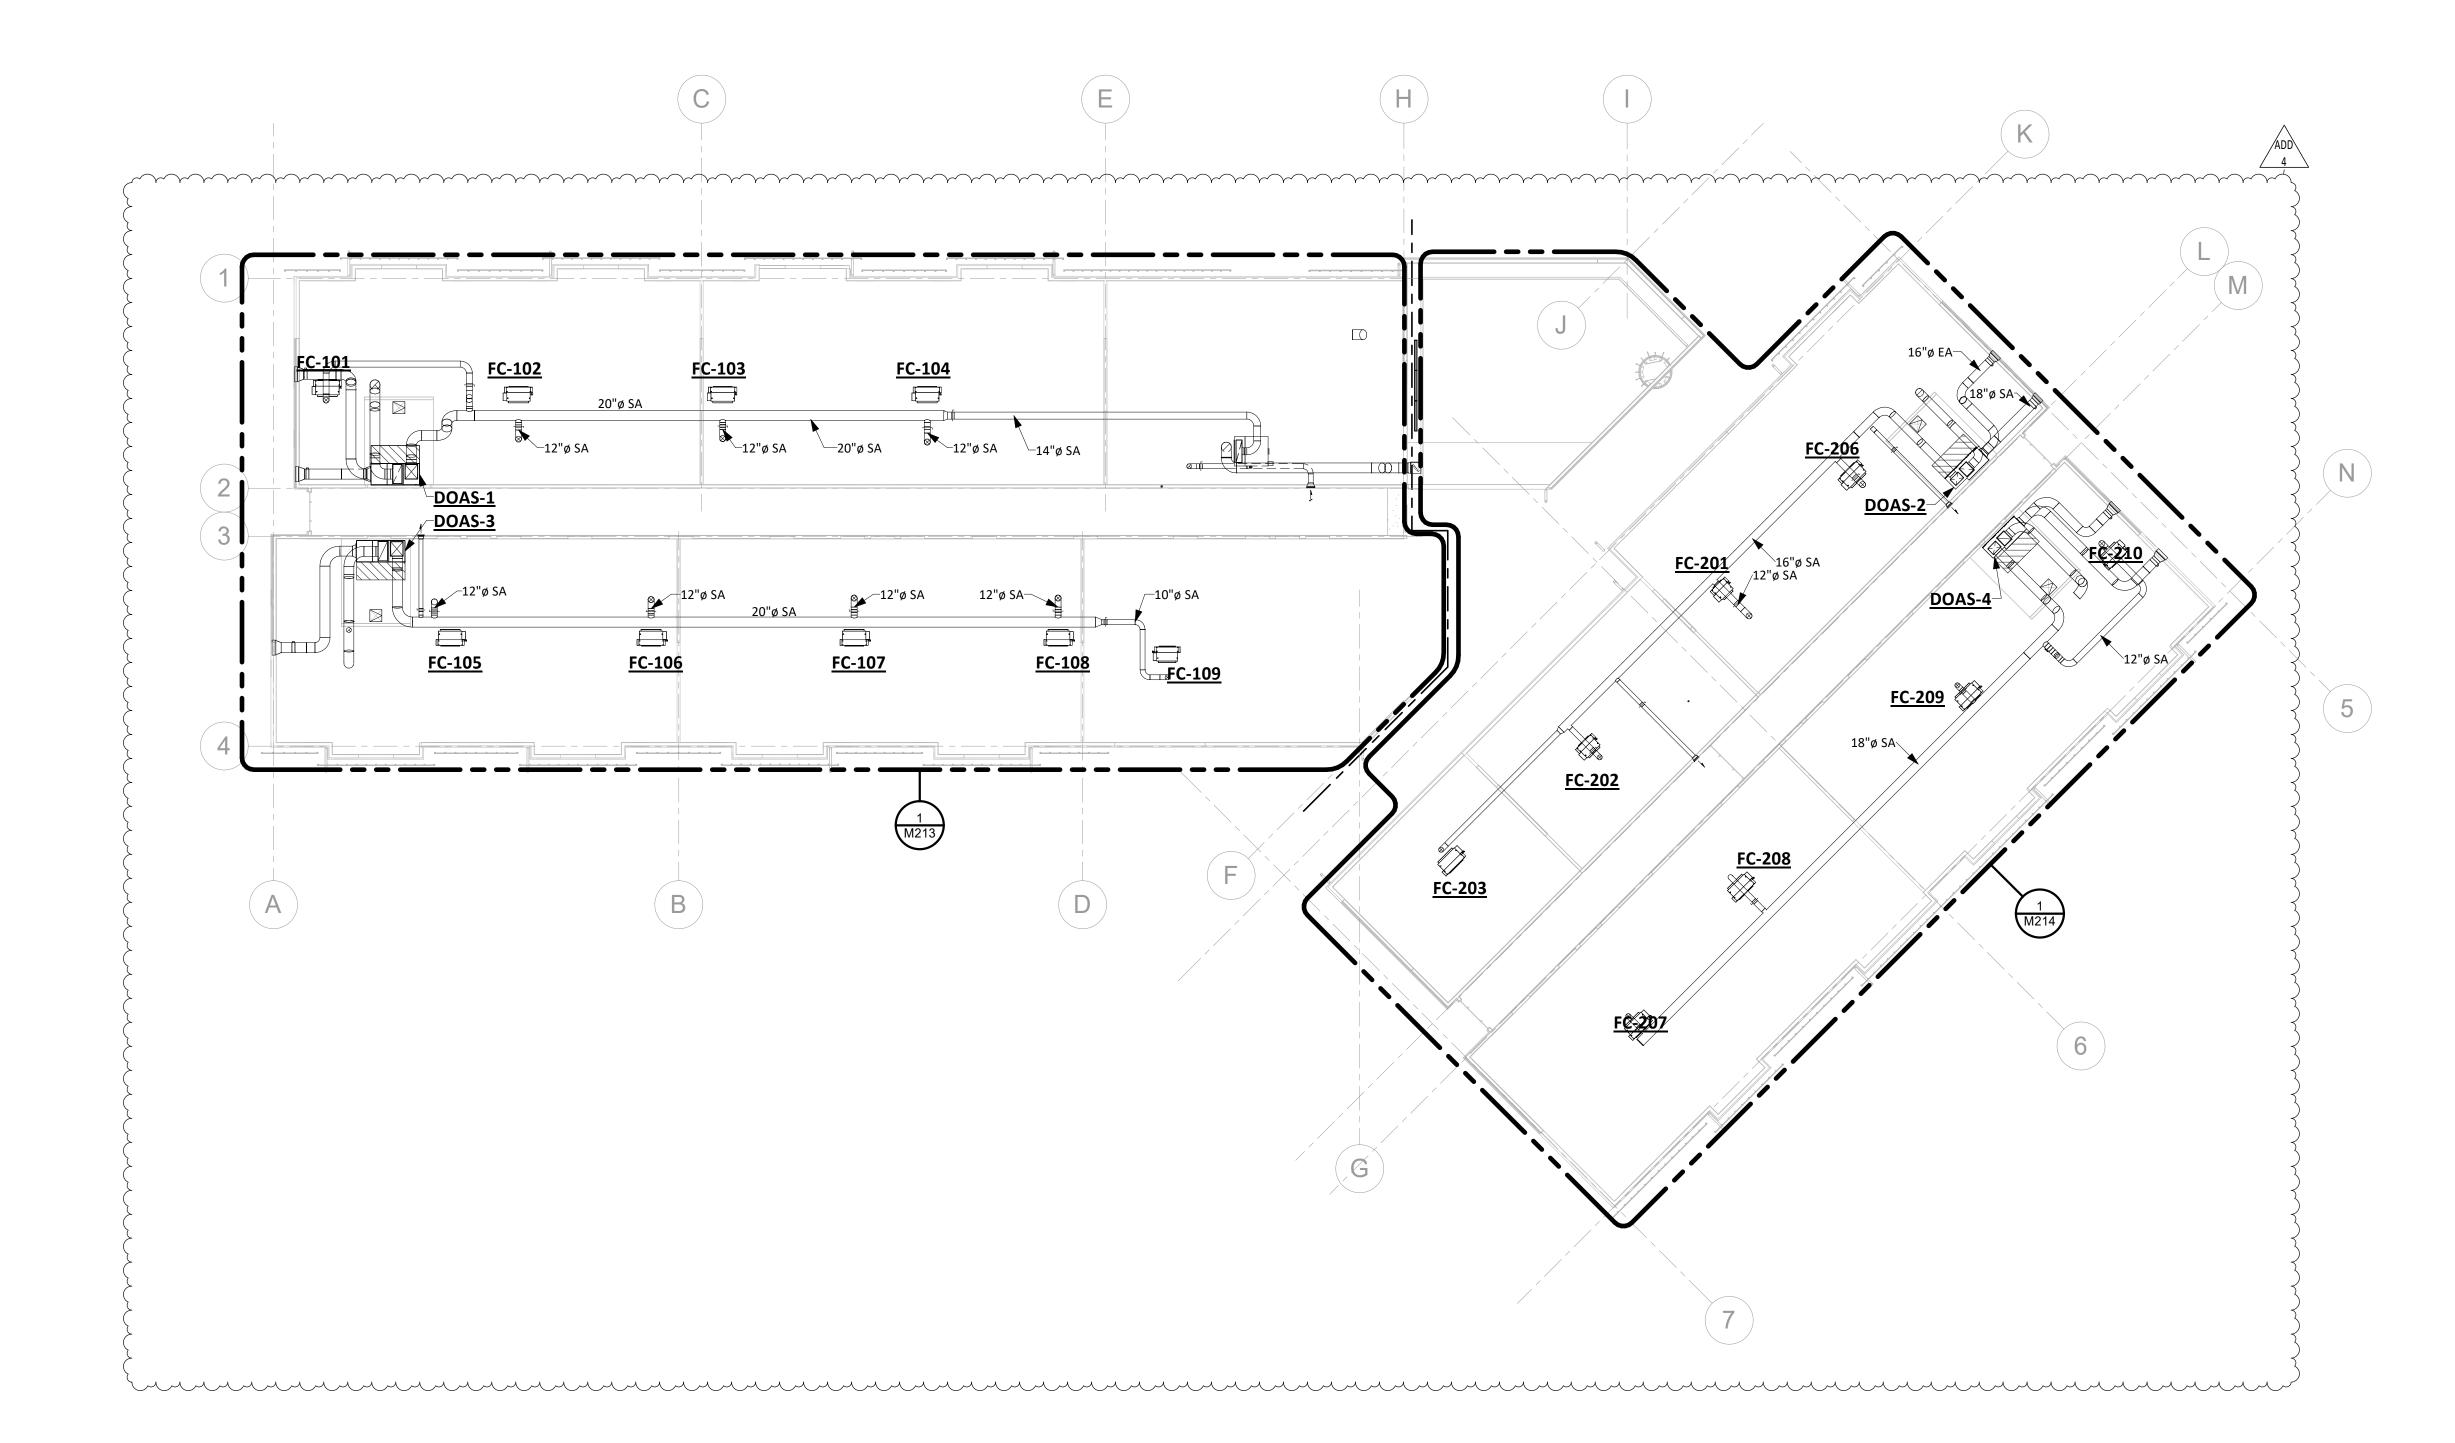










SHEET TITLE:

**MECHANICAL** -MEZZANINE

REVISIONS: # DESCRP. ADD 4

ISSUE DATE: 08/26/2025

**KEY NOTES** 

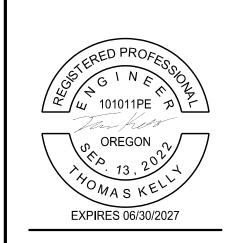


KCC CHILDC CENTER


SHEET TITLE: FIRST FLOOR -SECTOR A -**HVAC** 

REVISIONS:

# DESCRP. ADD 4

ISSUE DATE: 08/26/2025

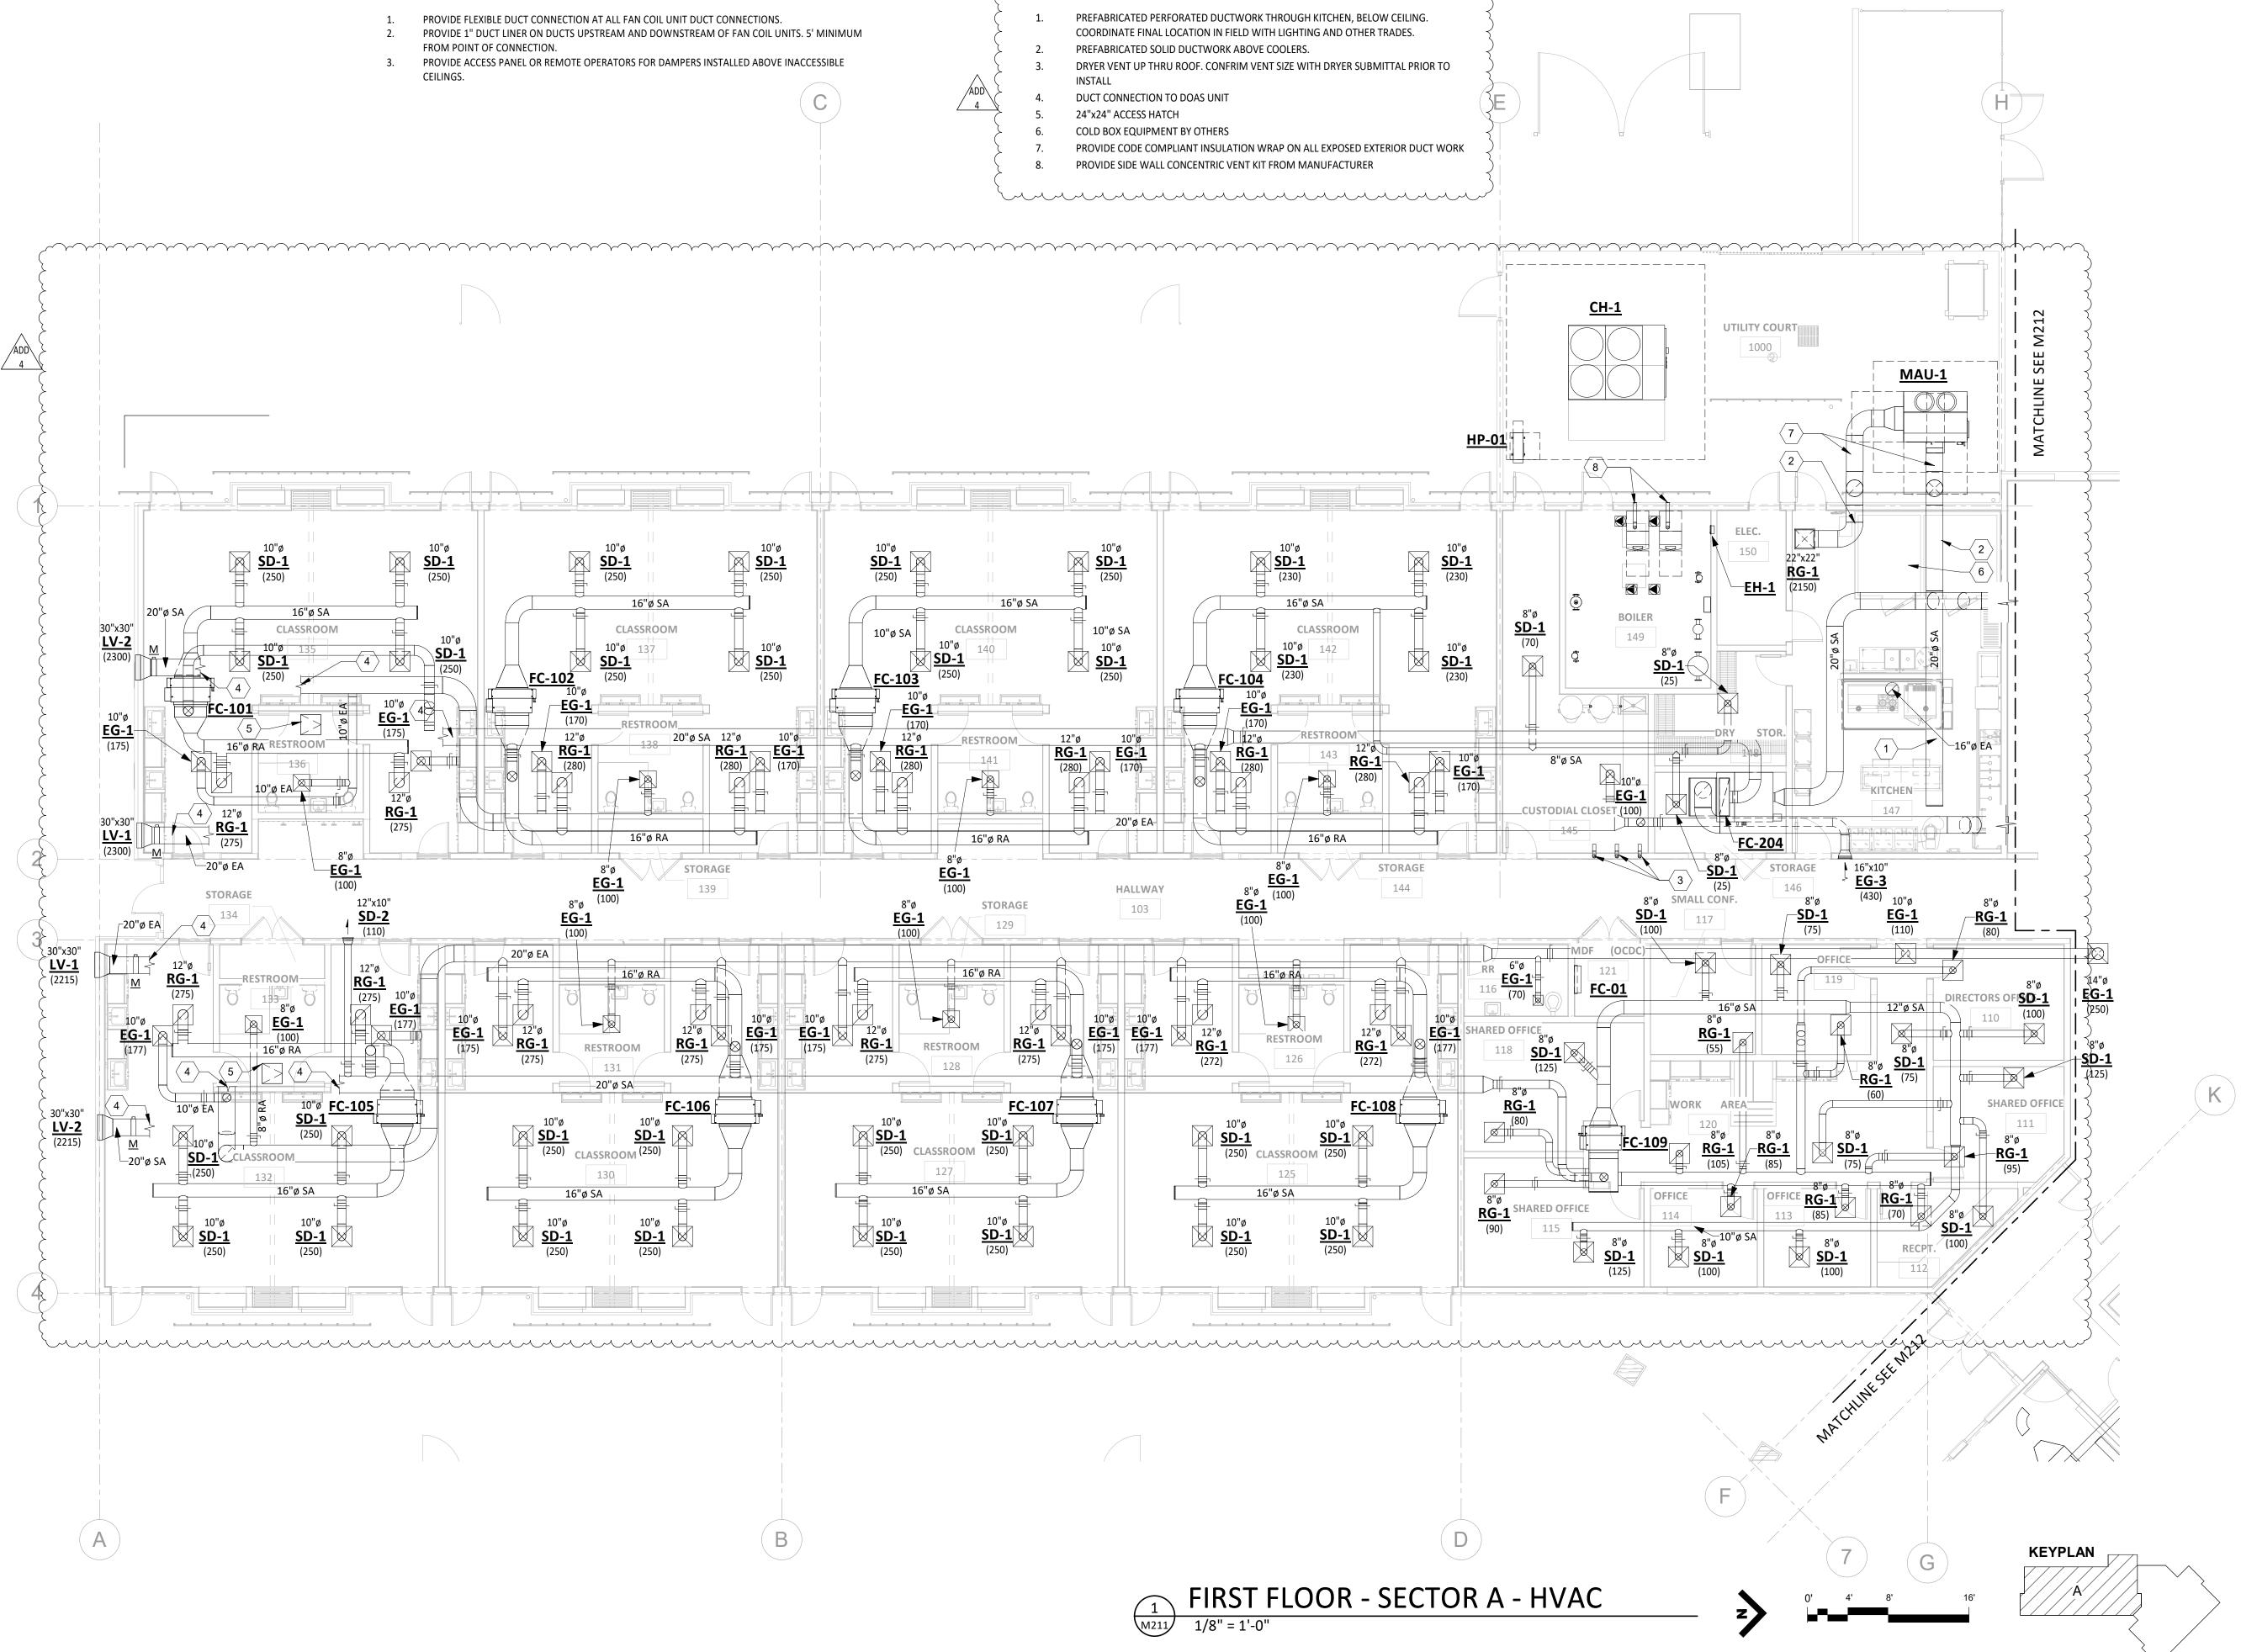

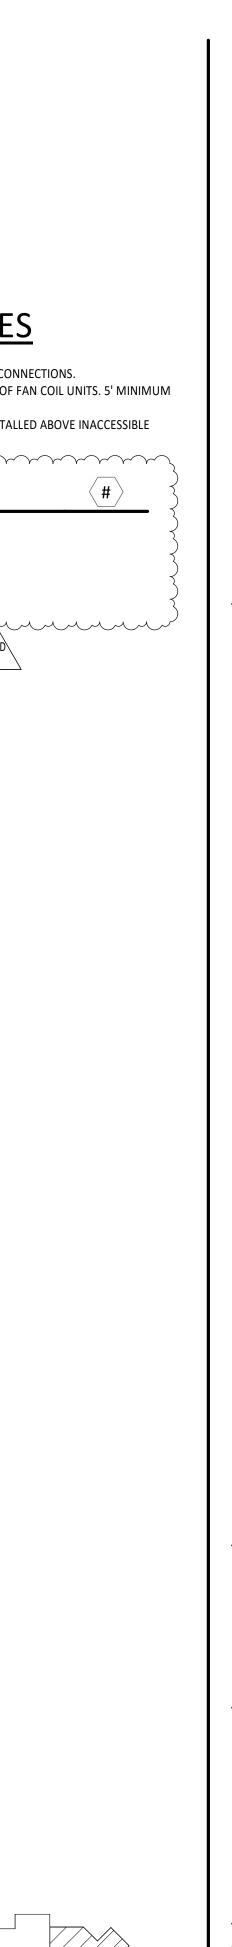


KCC CHILDC CENTER

EXPIRES 06/30/2027

SHEET TITLE: FIRST FLOOR SECTOR B -**HVAC** 

REVISIONS: # DESCRP.

ISSUE DATE: 08/26/2025

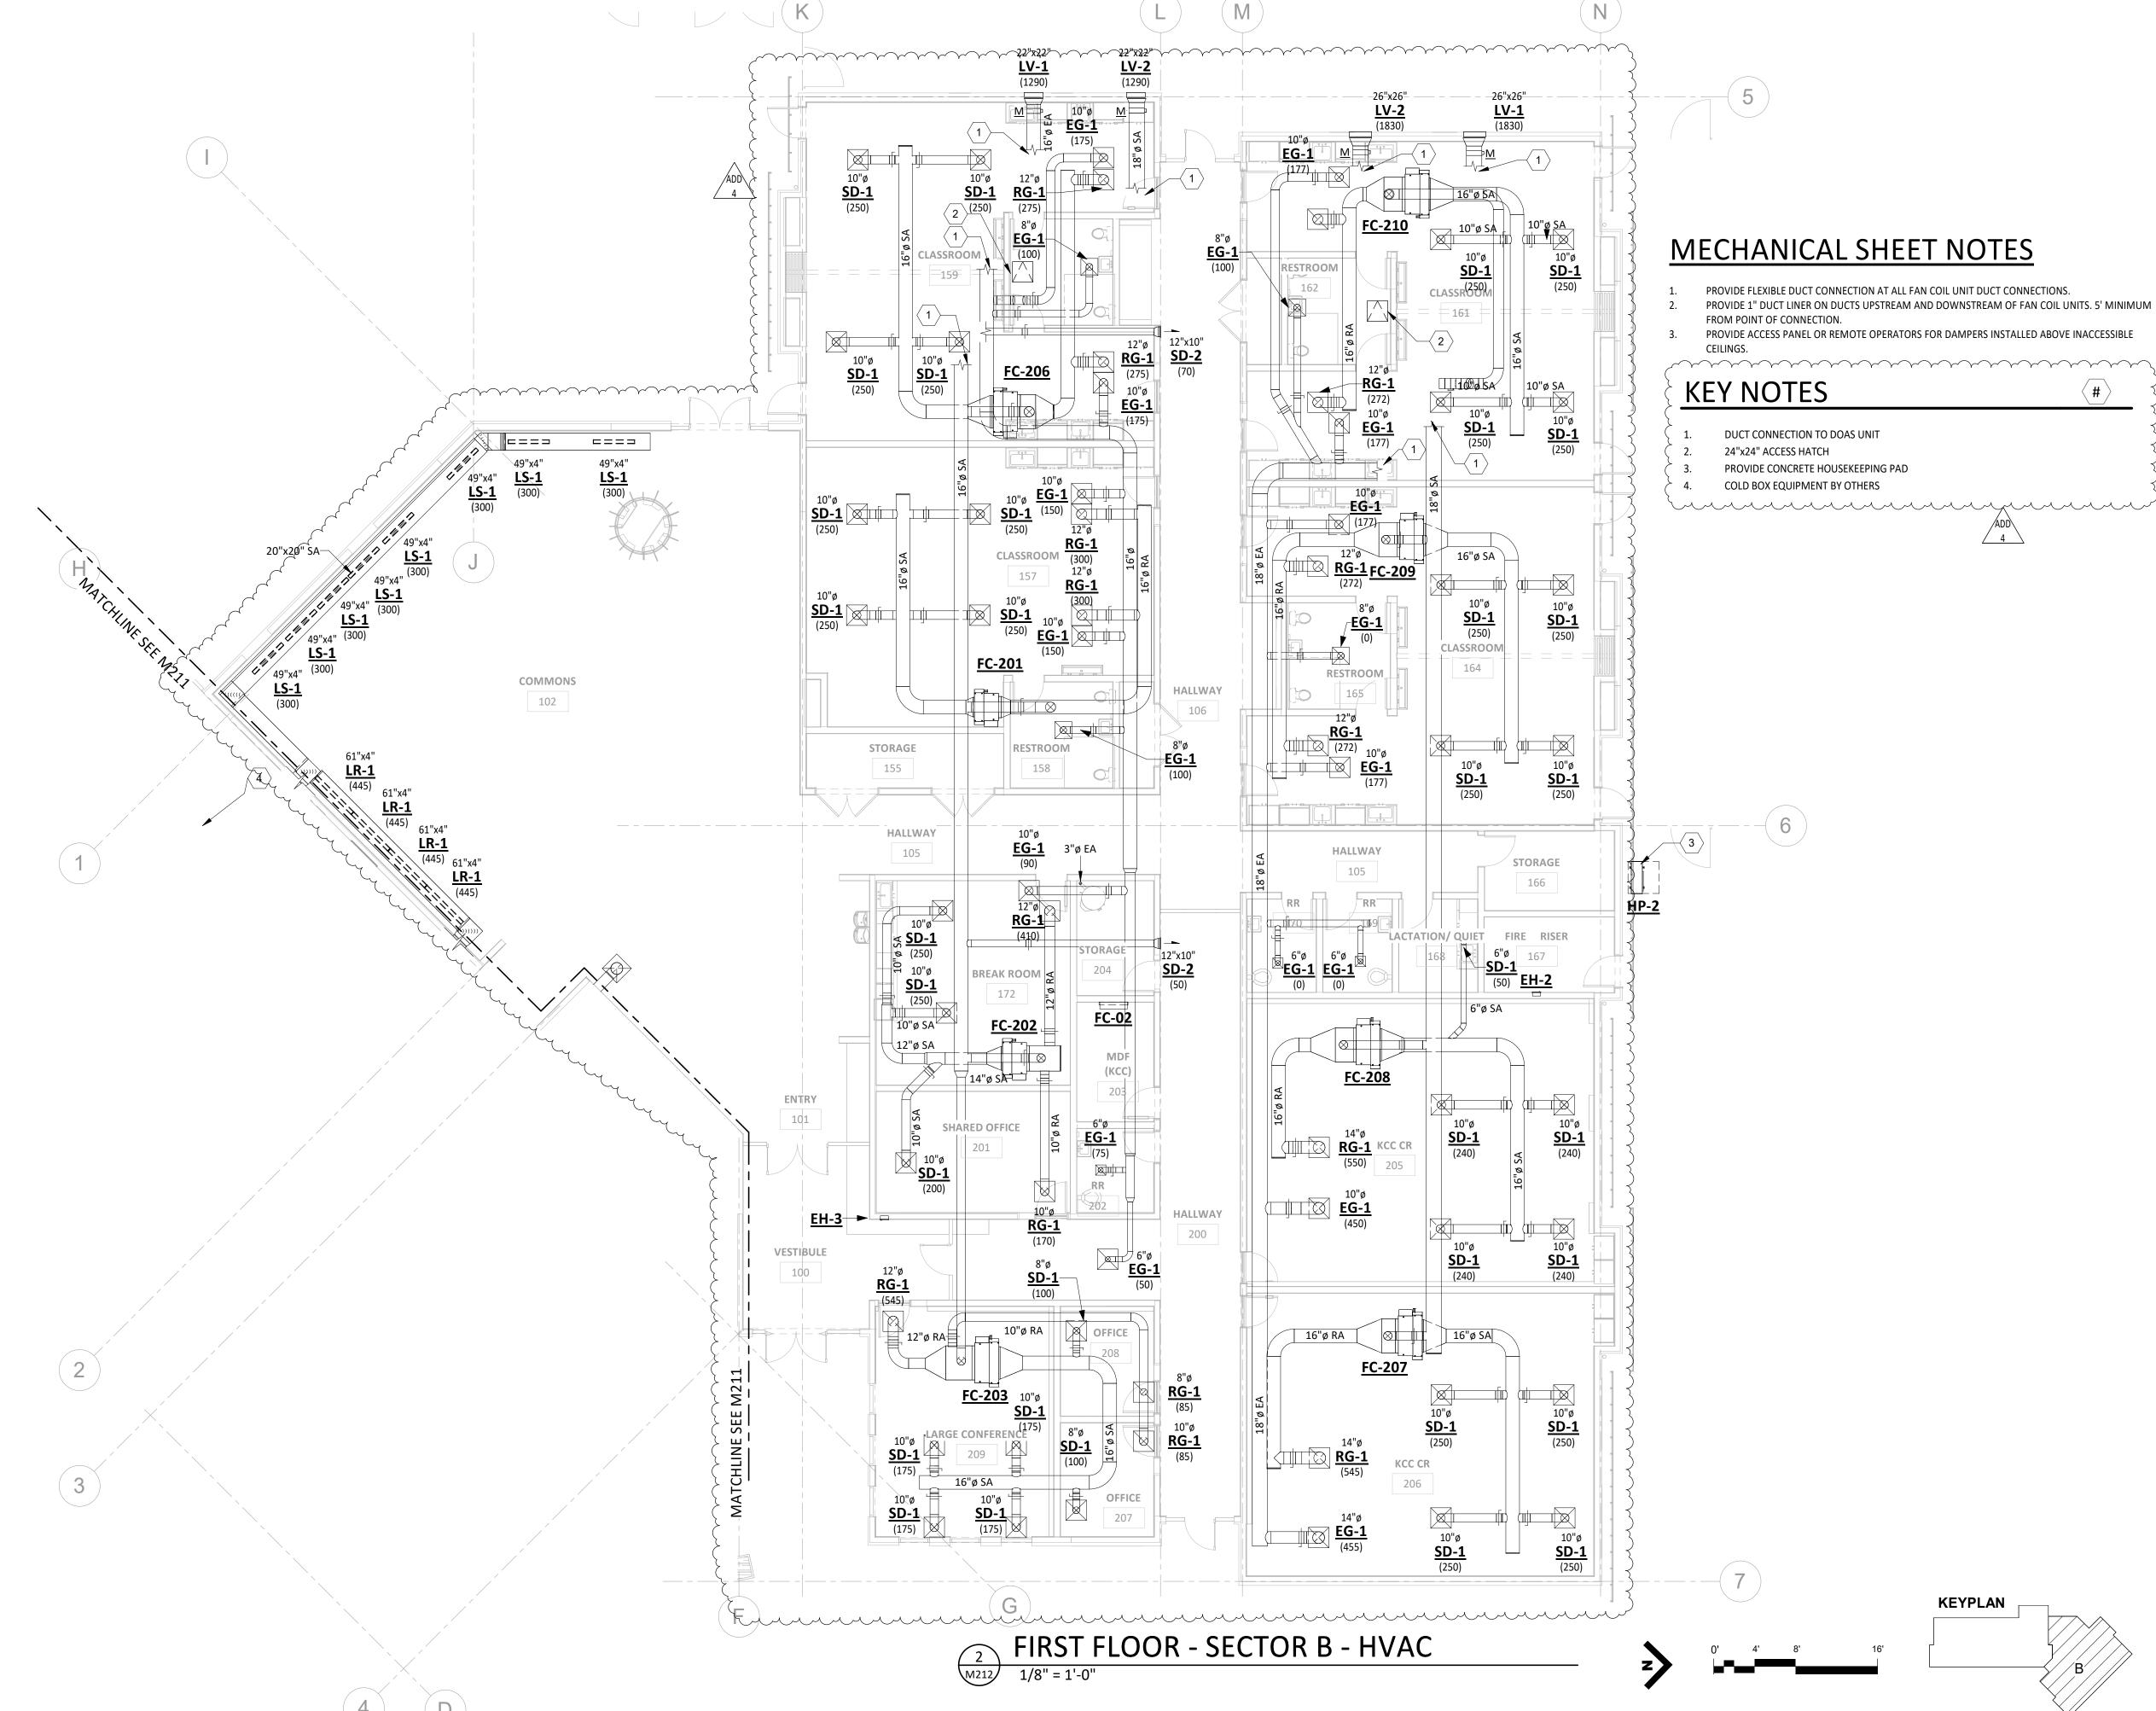


# MECHANICAL SHEET NOTES


- PROVIDE FLEXIBLE DUCT CONNECTION AT ALL FAN COIL UNIT DUCT CONNECTIONS.
  PROVIDE 1" DUCT LINER ON DUCTS UPSTREAM AND DOWNSTREAM OF FAN COIL UNITS. 5' MINIMUM FROM POINT OF CONNECTION.
- PROVIDE ACCESS PANEL OR REMOTE OPERATORS FOR DAMPERS INSTALLED ABOVE INACCESSIBLE

# **KEY NOTES**




1. 24"x24" ACCESS HATCH

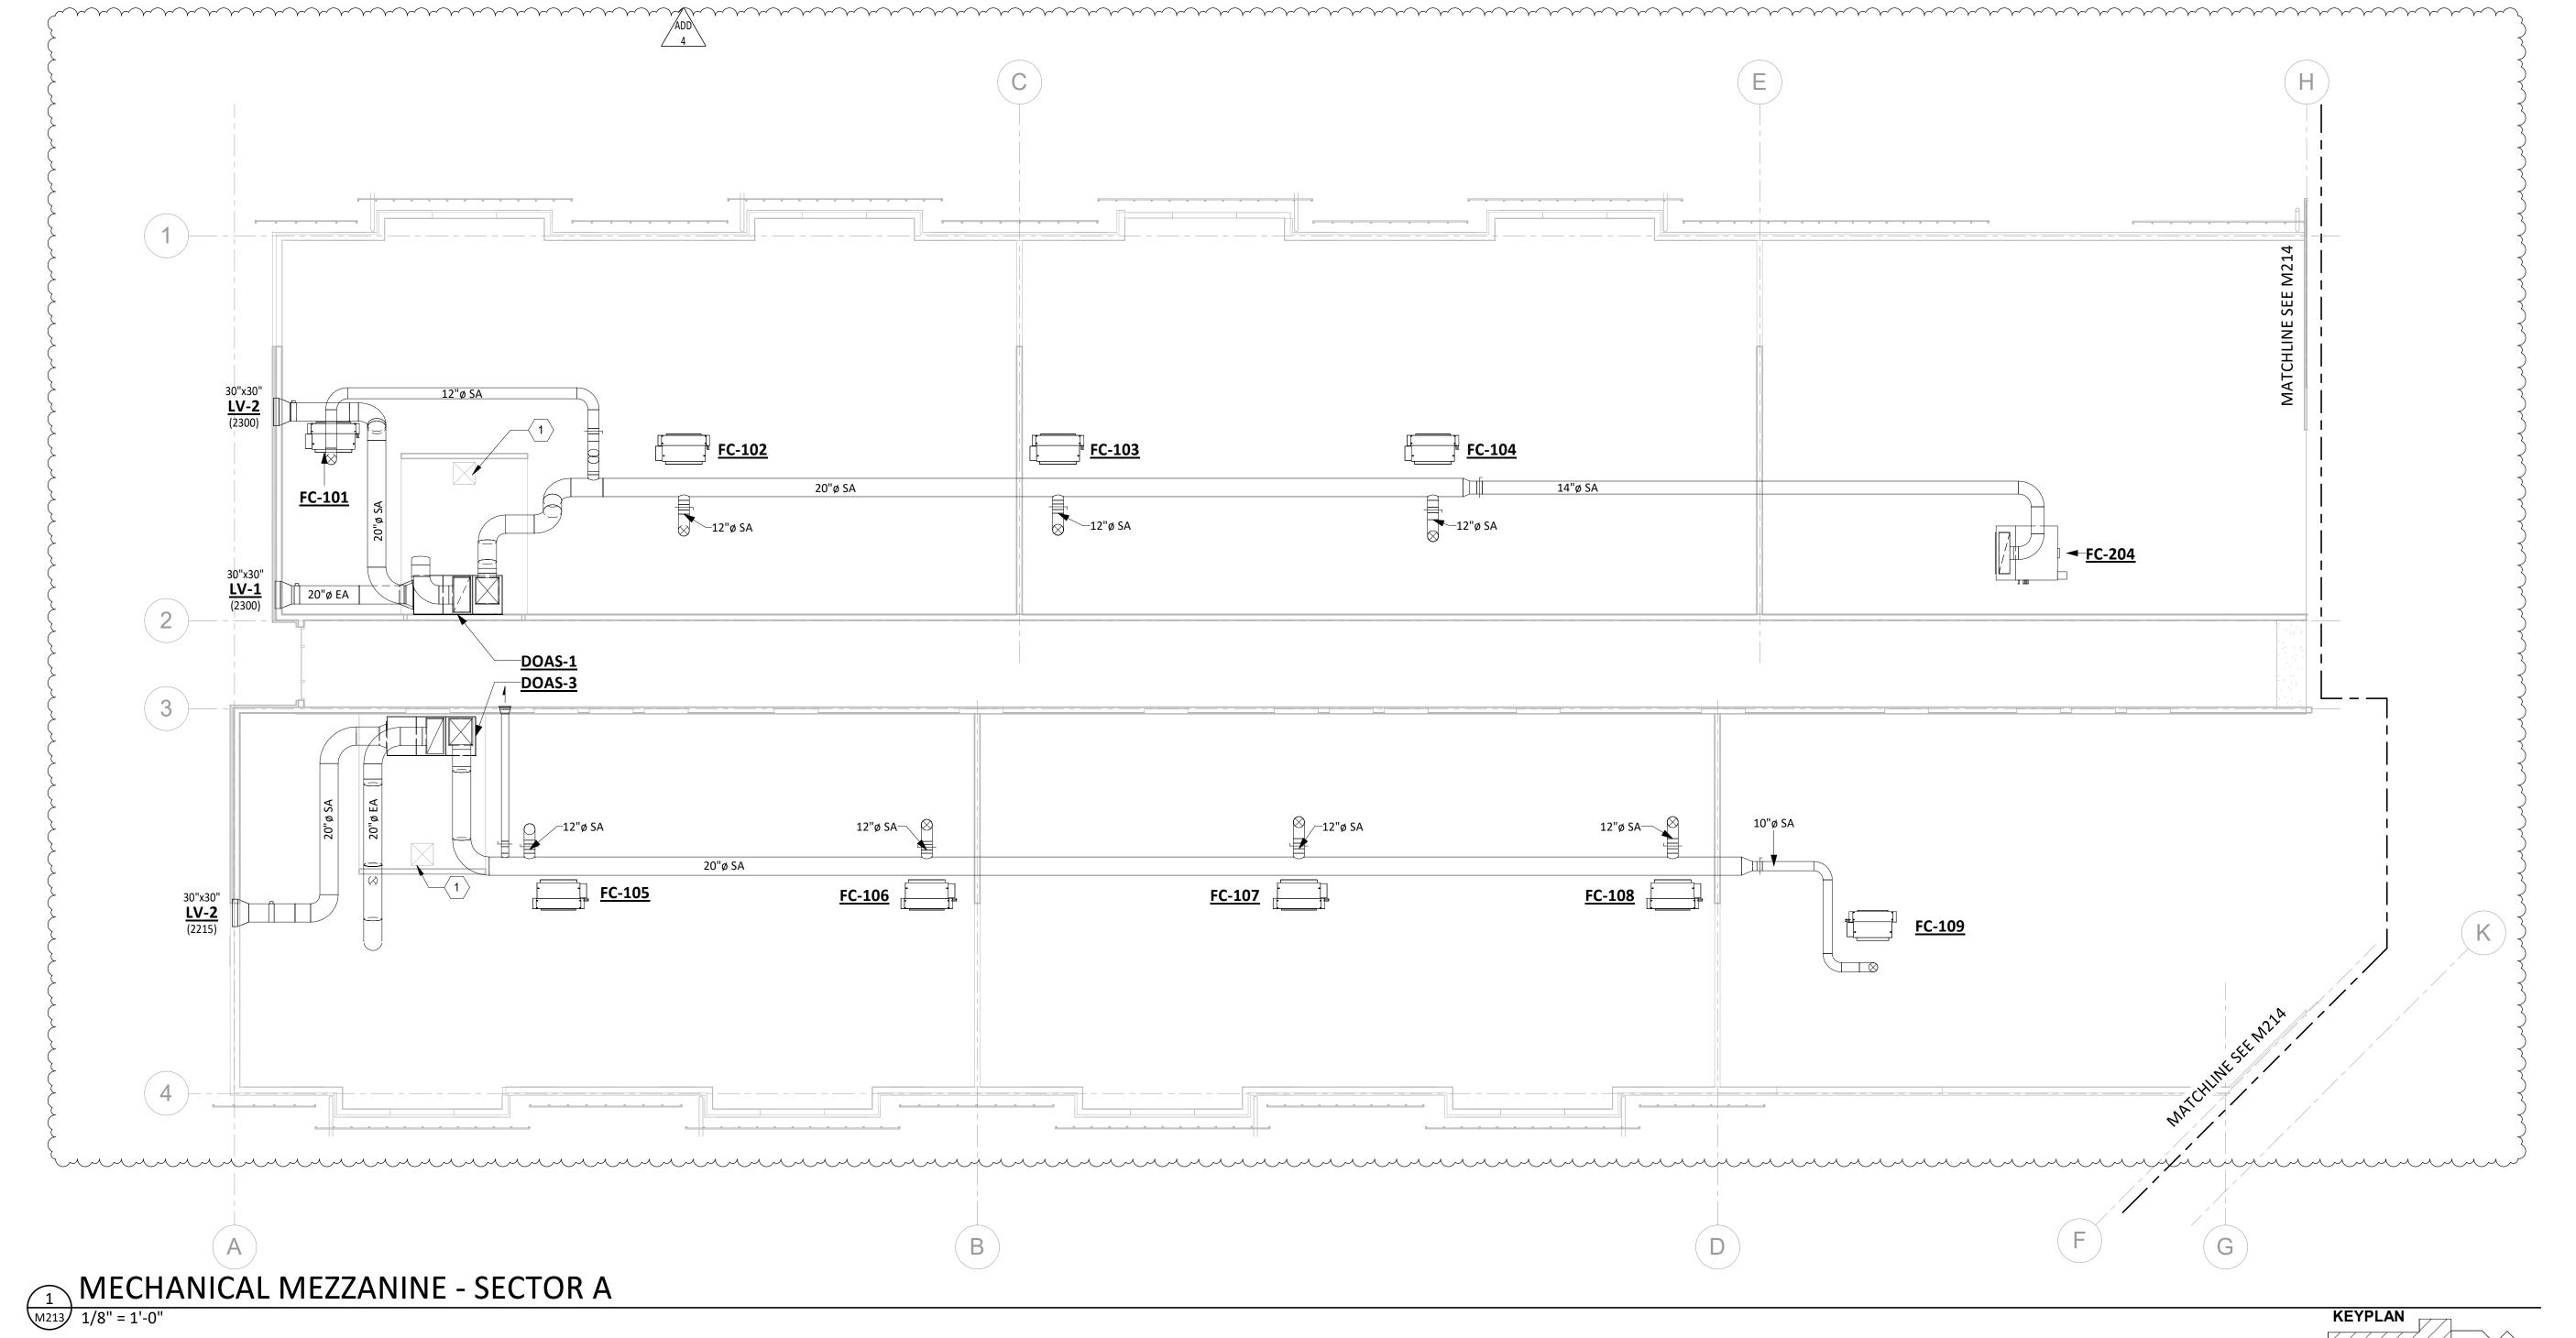

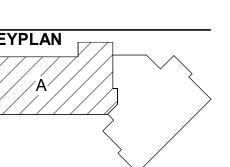




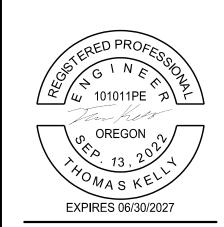

SHEET TITLE: **MEZZANINE** -SECTOR A -**HVAC** 

REVISIONS:

ISSUE DATE: 08/26/2025

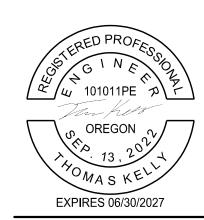

SHEET TITLE: **MEZZANINE** -SECTOR B -**HVAC** 

REVISIONS:

ISSUE DATE: 08/26/2025

M214

MECHANICAL MEZZANINE - SECTOR B

1
M214
1/8" = 1'-0"



EXPIRES 06/30/2027

SHEET TITLE:


FIRST FLOOR -SNOWMELT

REVISIONS: # DESCRP. DATE


ISSUE DATE: 08/26/2025



											Snow Me	lt		_						_		
Name	Area [ft²]	Circuits	Pan	el Type	Layer Thi	ckness <sup>1</sup> To	otal Tube Dep [in]	th (Center	, I	lelting Load stu/hr]	Backloss [Btu/hr]	Total Load [Btu/hr]	Unit Load [Btu/(hr·ft²)]	Unit Back   [Btu/(hr·		Insulation		oss Mode tu/hr]	Surface Temp [°F]	Snow Fr	ee Ratio	Confidence
Snow Mel	lt 1,744	9	Snow Me	lt - Concrete	4.0 in (	Slab)	3.4 ir	1	21	2,965	21,547	234,512	122.1	12.4		5.0 hr·ft²·°F/btu	ı Cald	culated	33	1-0	Clear	95%
<sup>1</sup> Thickness of <sup>2</sup> Total Tube de	the layer in wh epth measured	ich tubing is emi from top of sno	w melting surface	ce to center of tubin														·				
				ircuit Inform												ifolds					1	
	ength T	ube Size	Spacing [ in ]	Manifold	Flow [USGPM]	Head Loss [ ft water ]	Total Load [ Btu/hr ]	Color	Name		Manifo	ldType		# Circuits	Tubing			TotalFlow [USGPM]	Head Loss [ft water]	otal Load [Btu/hr]	ı	Fluid
M1.1	249	3/4"	9	Manifold 1	1.67	6.5	23,117		Manifold 1	Copper, 1-1/2	2" w/ Shut-0	Off and Balan	cing Valves	9	3/4	l" 1	11	16.97	11.6	234,512	40% Pro	pylene Glycol
M1.2	286	3/4"	9	Manifold 1	1.94	9.7	26,851										•					
M1.4	261	3/4"	9	Manifold 1	1.78	7.6	24,637															
M1.5	277	3/4"	9	Manifold 1	1.91	9.1	26,415															
M1.6	283	3/4"	9	Manifold 1	1.96	9.7	27,052															
M1.7	292	3/4"	9	Manifold 1	2.02	10.5	27,932															
M1.8	249	3/4"	9	Manifold 1	1.69	6.6	23,339															
M1.9	303	3/4"	9	Manifold 1	1.98	10.6	27,354															
	202	2/4"		Monifold 1	2.01	10 E	27 045															

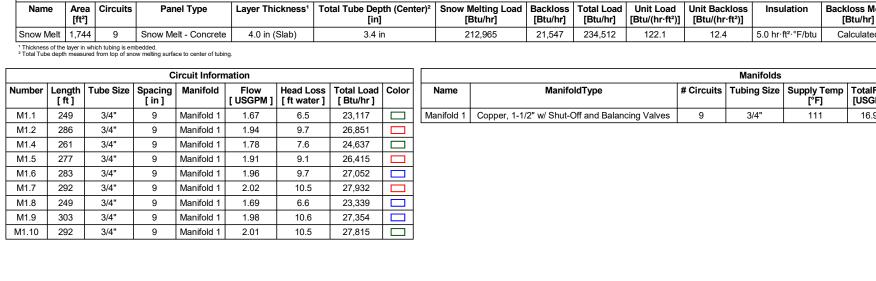



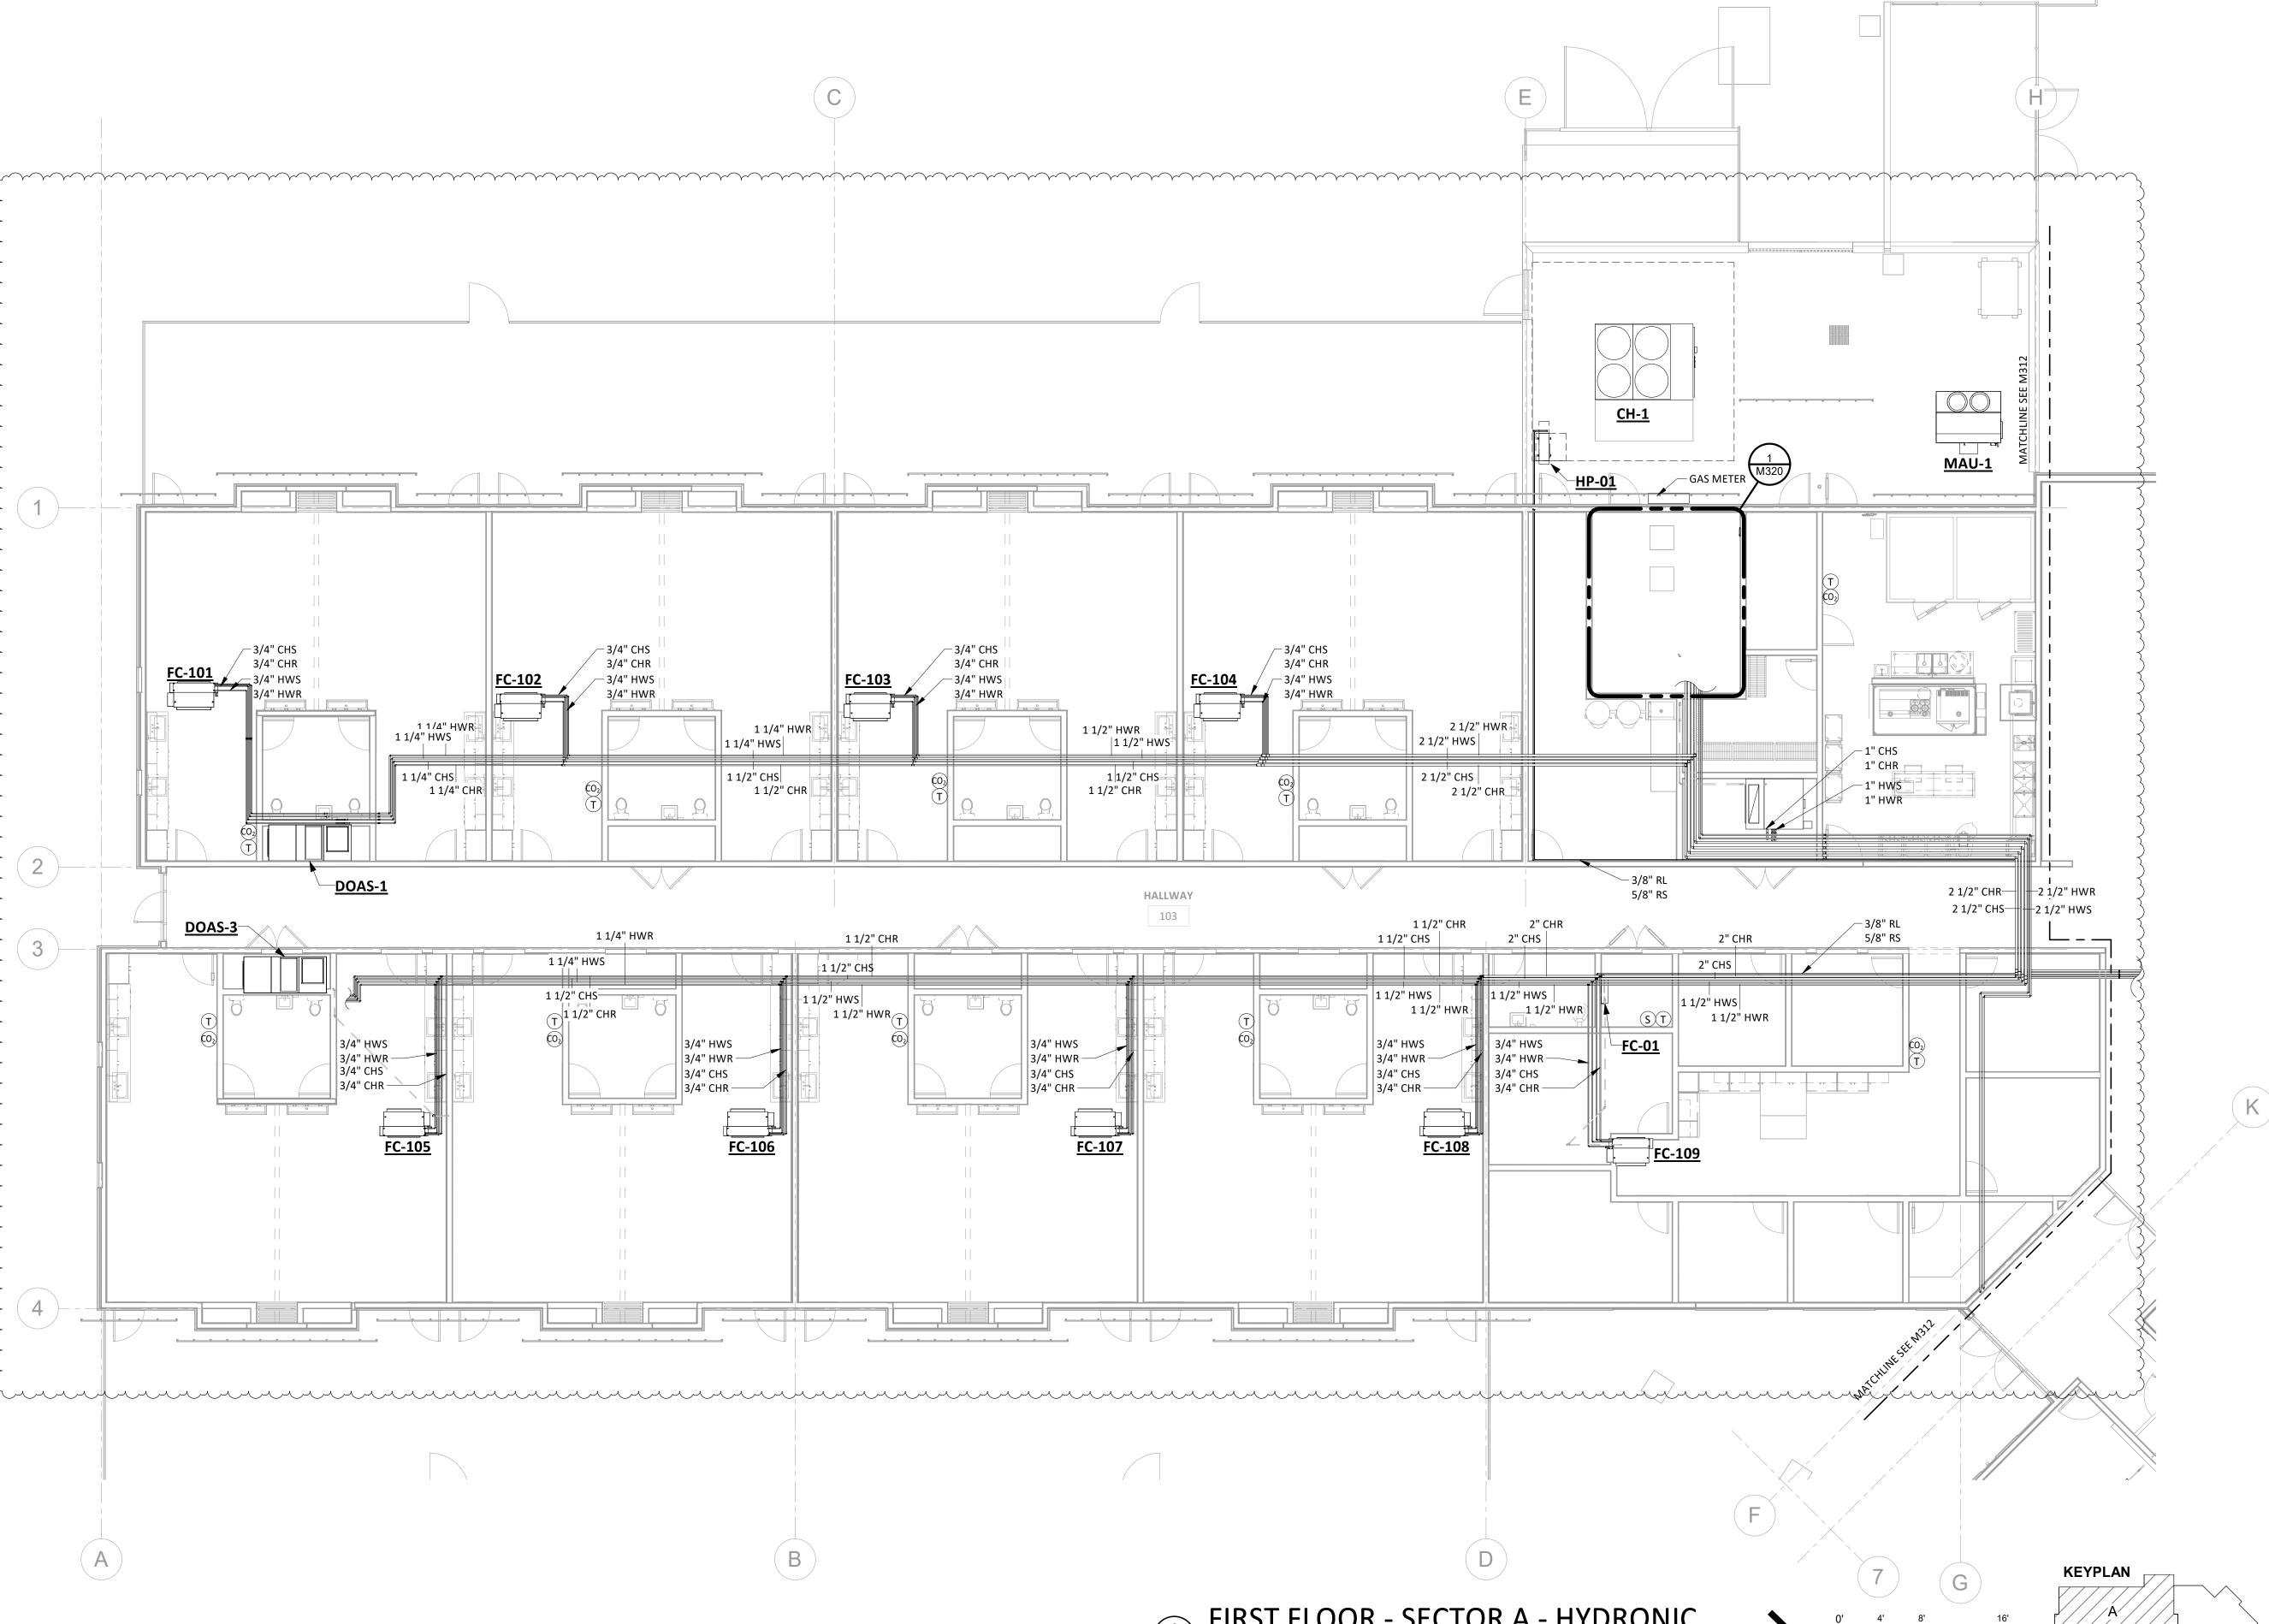





SHEET TITLE:

FIRST FLOOR -SECTOR A -**HYDRONIC** 

REVISIONS: # DESCRP.

ADD 4


ISSUE DATE: 08/26/2025

EXPIRES 06/30/2027

# DESCRP.1 ADD 4

ISSUE DATE: 08/26/2025


M312

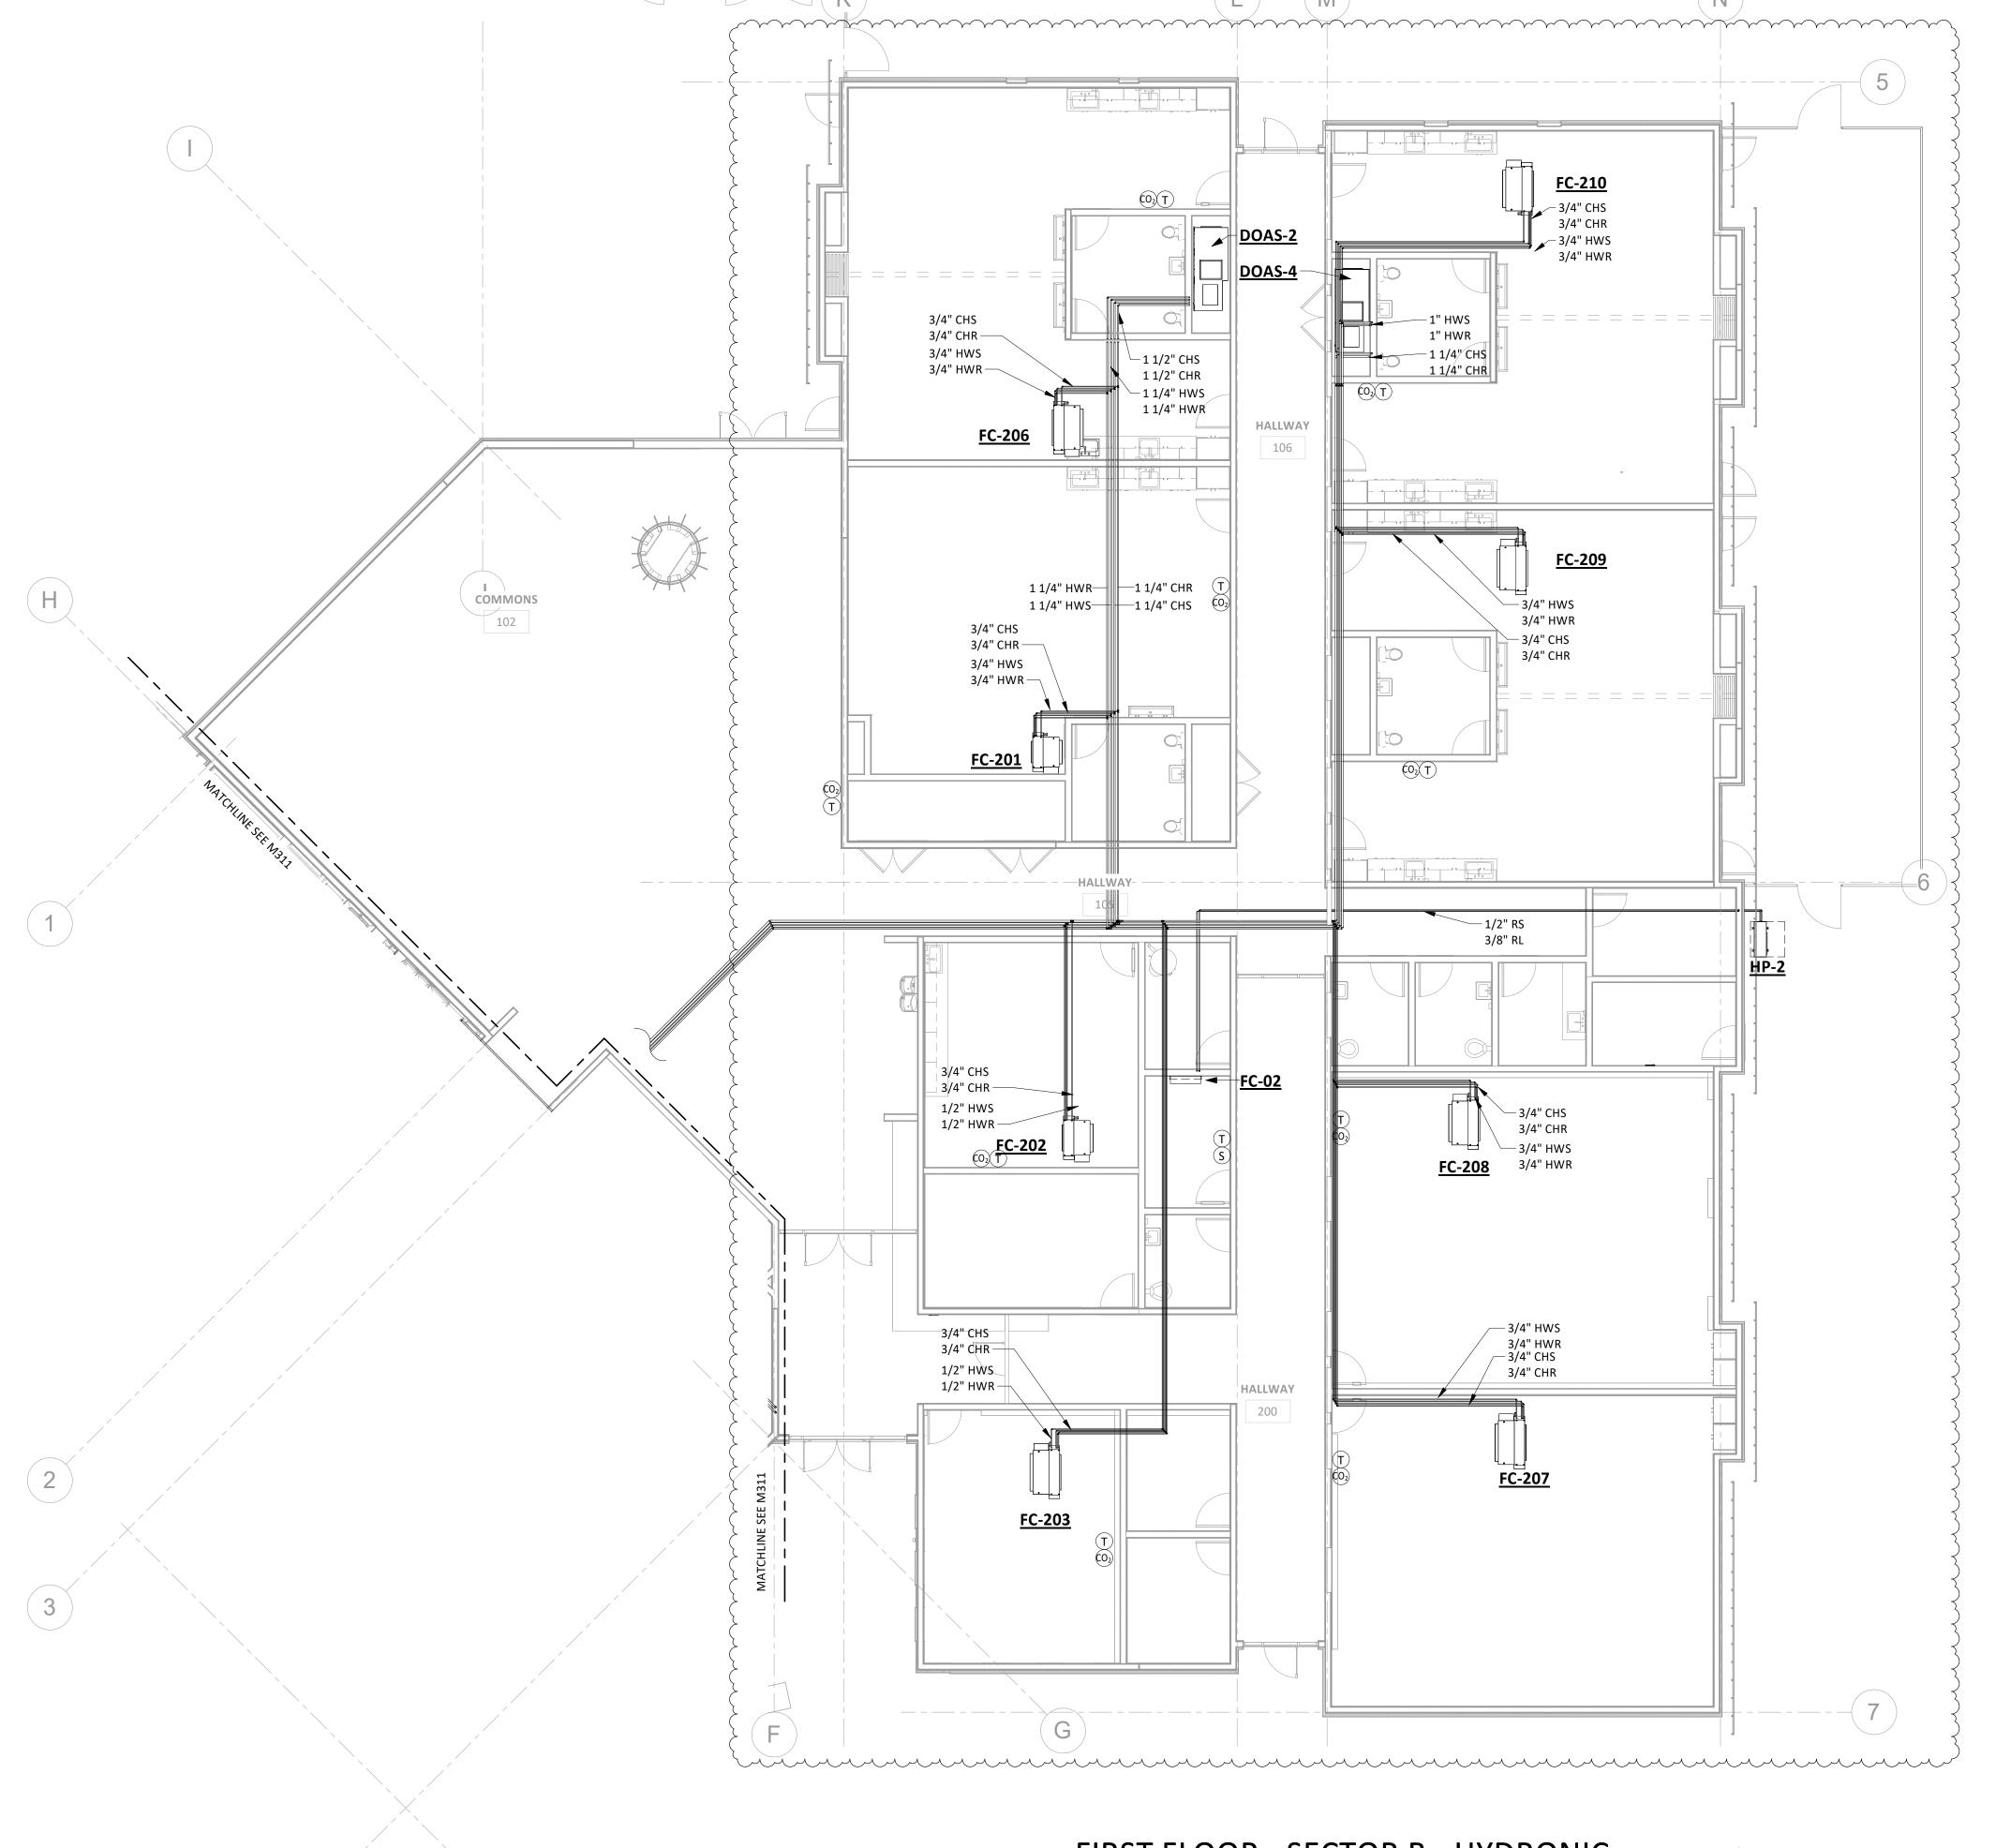



FIRST FLOOR - SECTOR B - HYDRONIC

IC\_\_\_\_

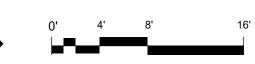



**KEYPLAN** 

**PLANS** 

M320

ISSUE DATE: 08/26/2025

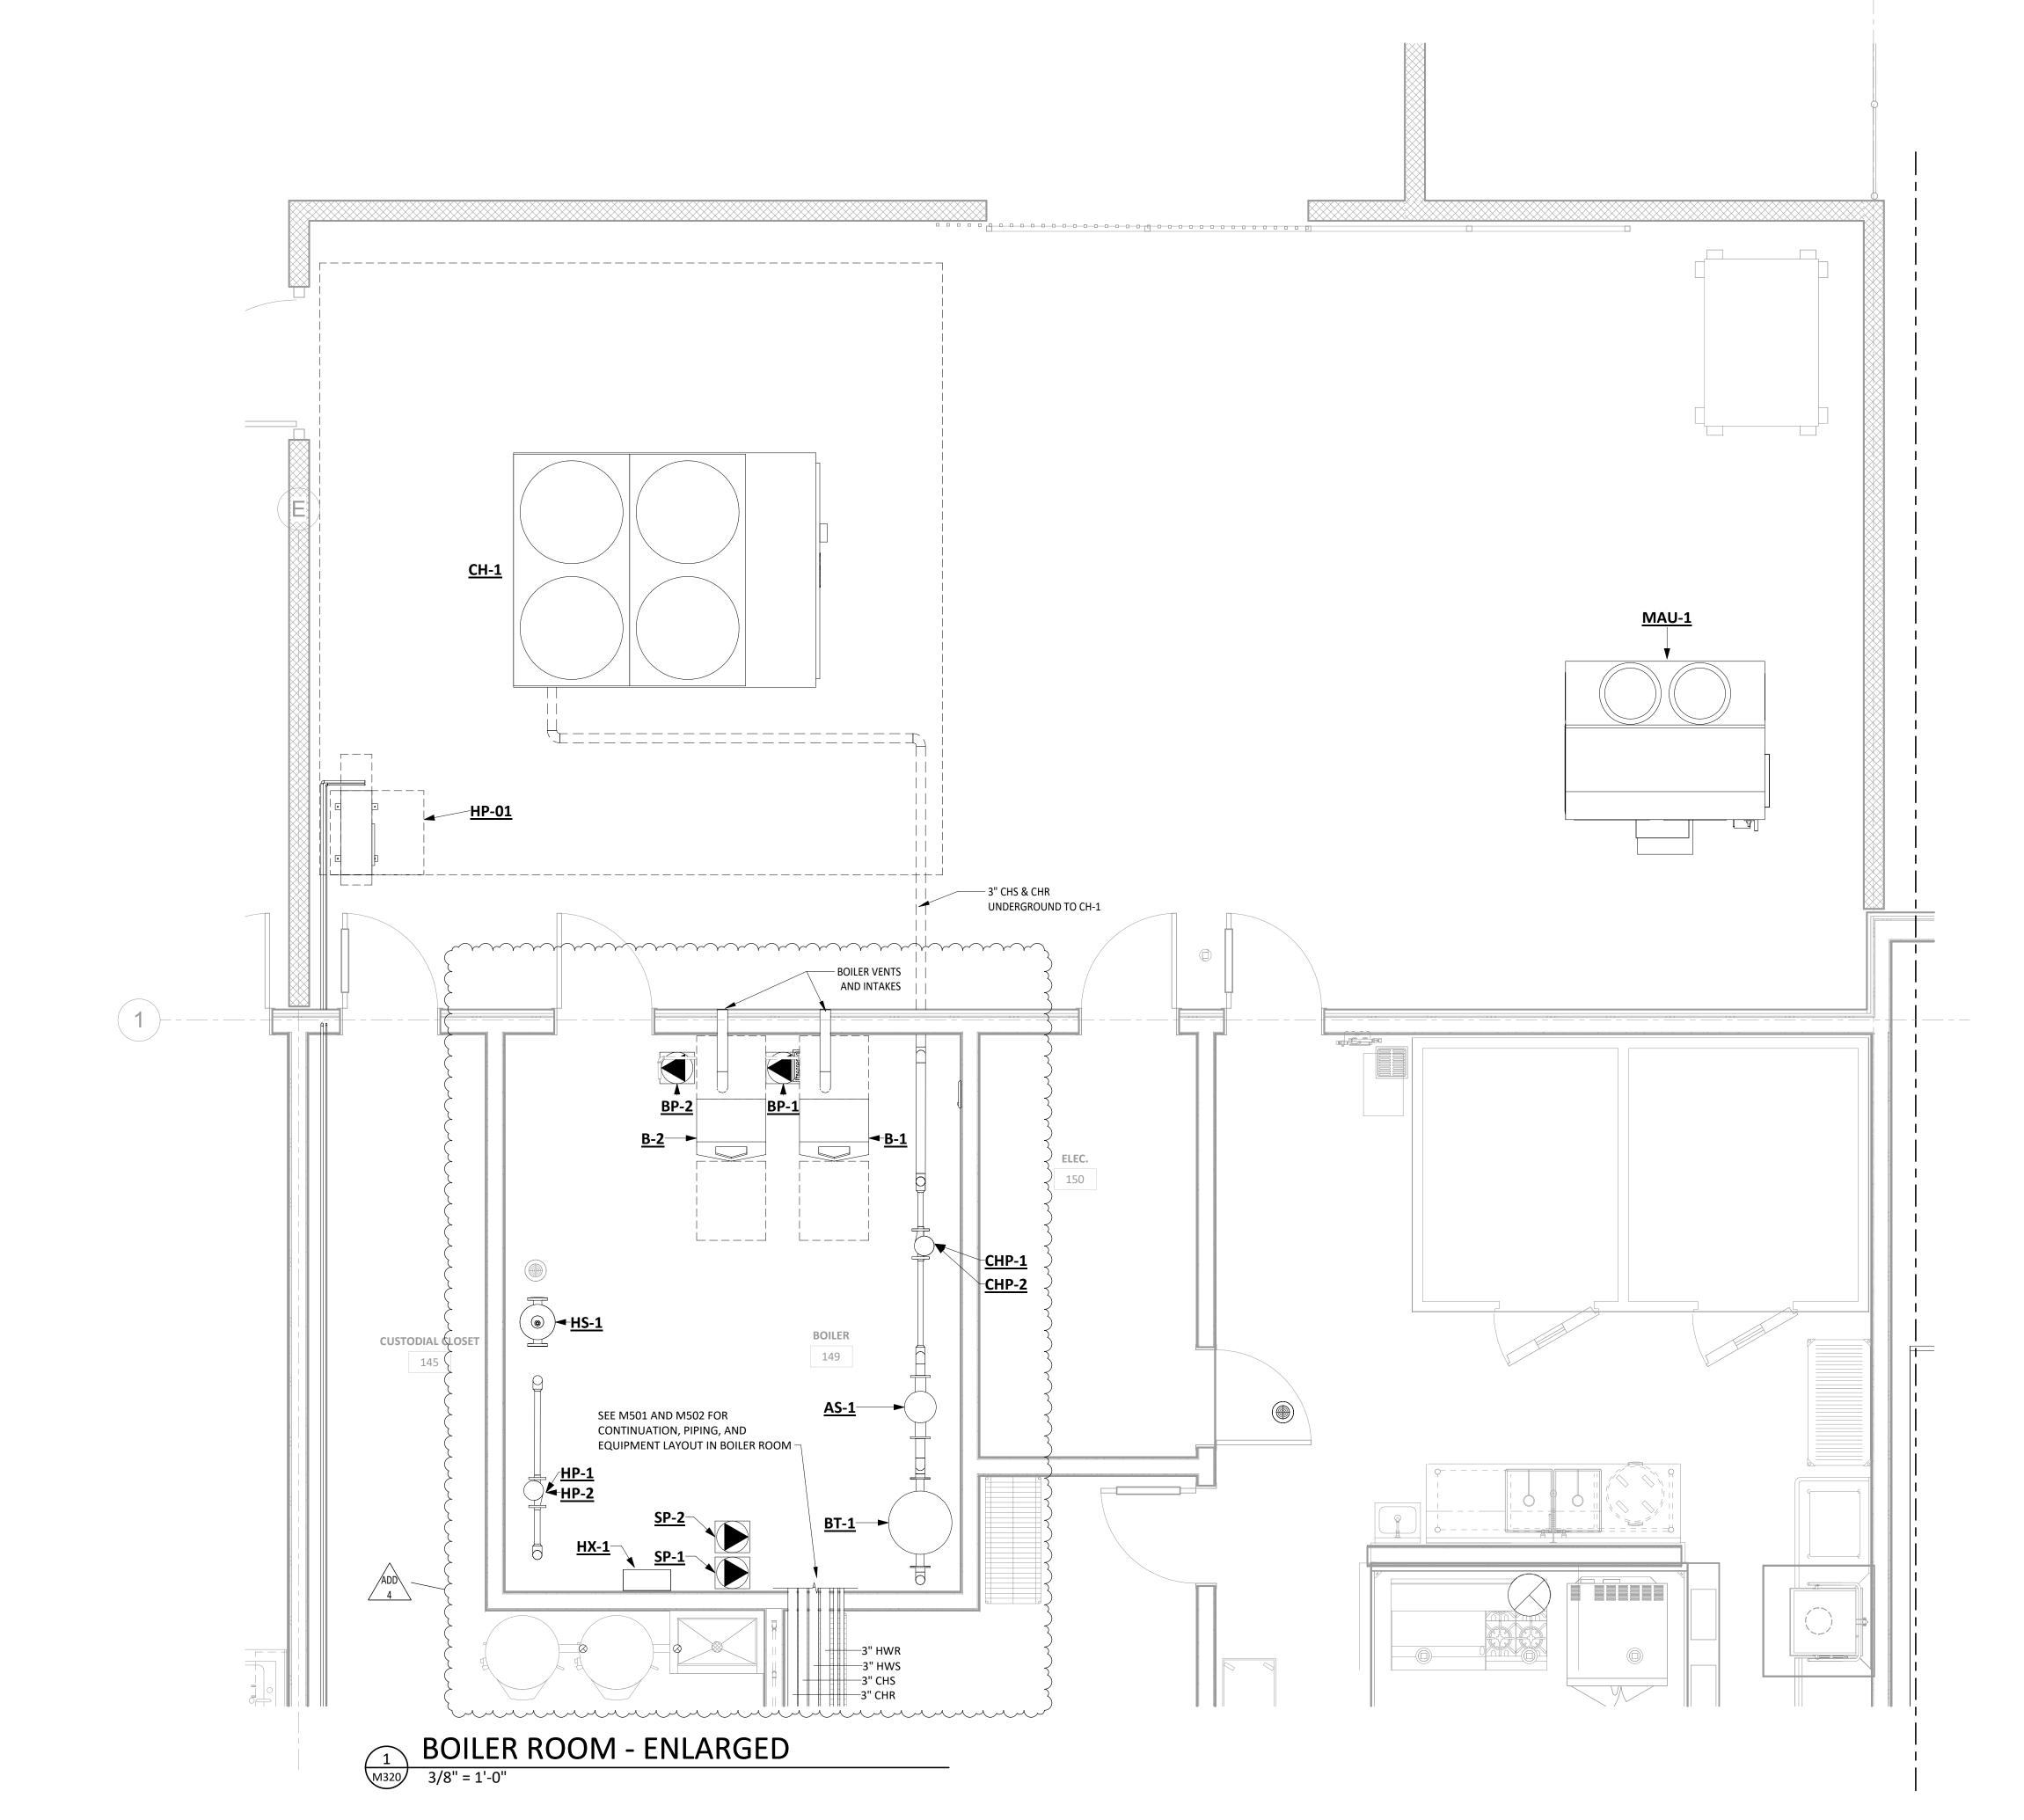

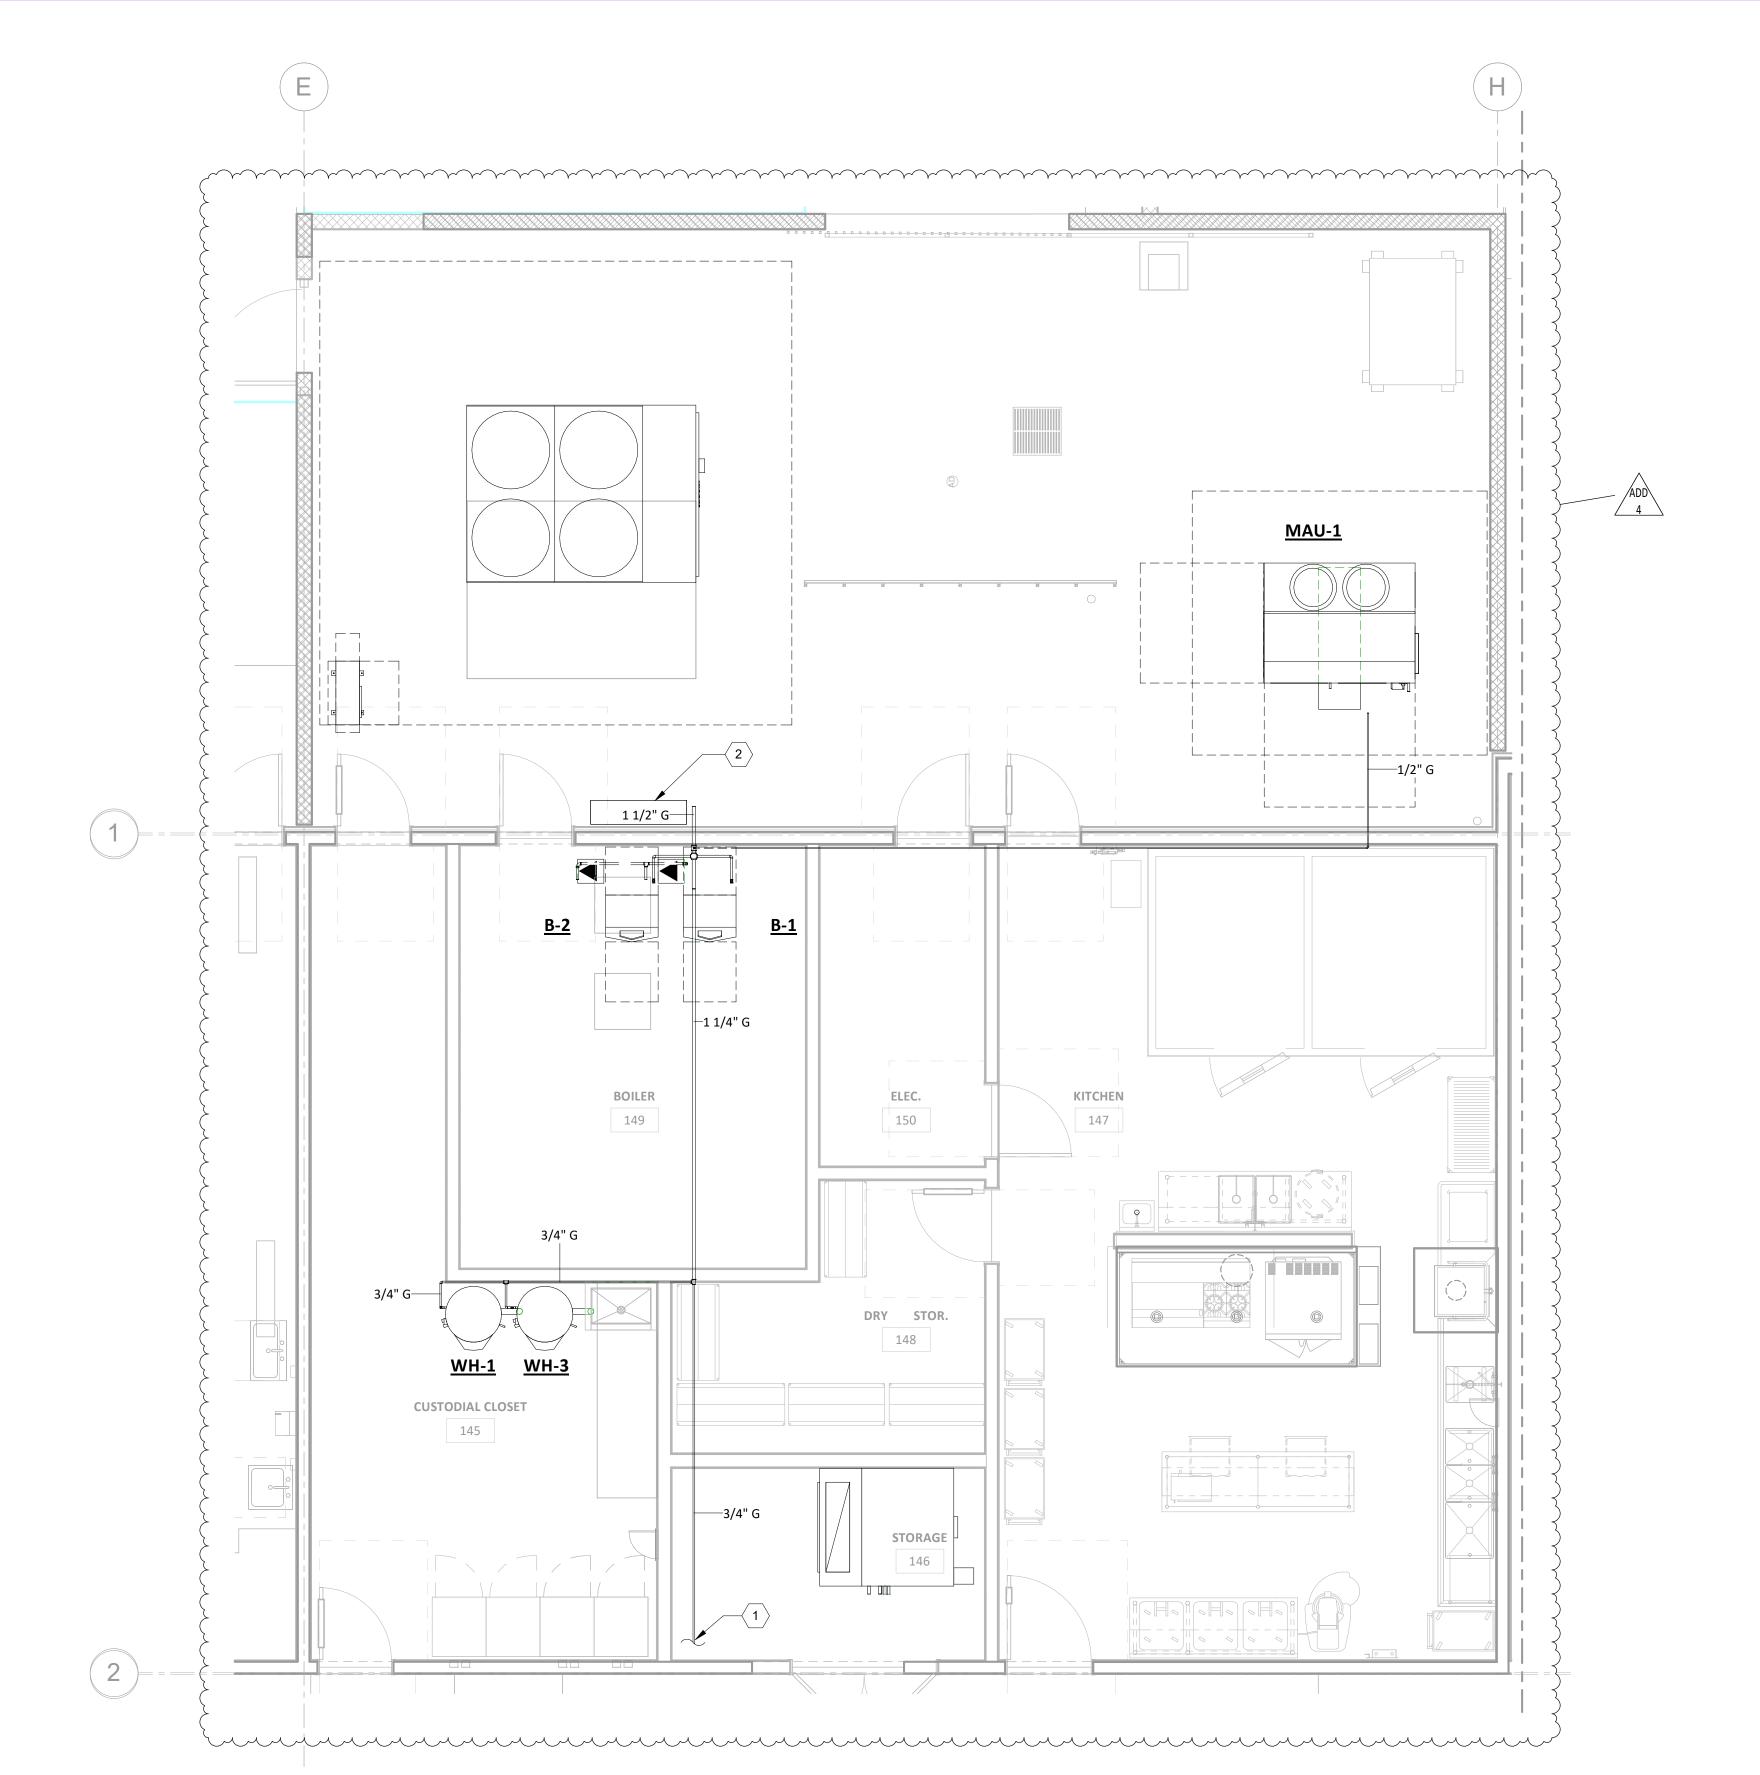

MARK	FIXTURE NAME	МВН	BRANCH SIZE (IN)	QTY	TOTAL MBH
<u>B</u>	BOILER	500	3/4	2	1000
<u>WH</u>	WATER HEATER	125	1/2	2	250
MAU	Make Up Air Unit	180	1/2	1	180
<u>WH</u>	WATER HEATER	180	1/2	1	180
_					
_					
		,		TOTAL	1610

	MAIN LINE SIZING	
IN	IPUTS	UNITS
INPUT RATE	1610	CU FT/HR
UPSTREAM PRESSURE	2	PSIA
DOWNSTREAM PRESSURE	1	PSIA
DEVELOPED LENGTH	150	FT
	MAIN LINE SIZE	1 1/4

- SIZED IN ACCORDANCE WITH 2022 OMSC, C402.4 USING EQUATION 4-2 SCHEDULE 40 METALLIC PIPING.
- LENGTH IN ISOMETRIC DIAGRAM ARE APPROXIMATE AND MAY CHANGE DEPENDANT ON FIELD ROUTING.
- PROVIDE REGULATOR AT EACH PIECE OF EQUIPMENT, PROVIDE VENT LIMITER OR ROUTE VENT TO EXTERIOR.


# **KEY NOTES**




- GAS PIPE TO WH-2 SEE 3/M401 FOLLOW ROUTING OF HVAC HYDRONIC PIPING, SEE 3/M401.
- COORDINATE WITH CIVIL FOR METER SET LOCATION. COORDINATE WITH GAS UTILITY COMPANY FOR INSTALLATION OF HIGH PRESSURE GAS LINE TO METER. SET BUILDING SIDE





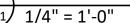

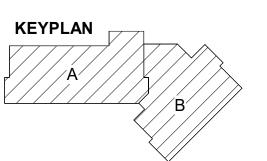







SHEET TITLE: FIRST FLOOR -GAS

REVISIONS: # DESCRP.

ADD 4


ISSUE DATE: 08/26/2025

ADD 4

08/29/2025

ISSUE DATE: 08/26/2025

M501

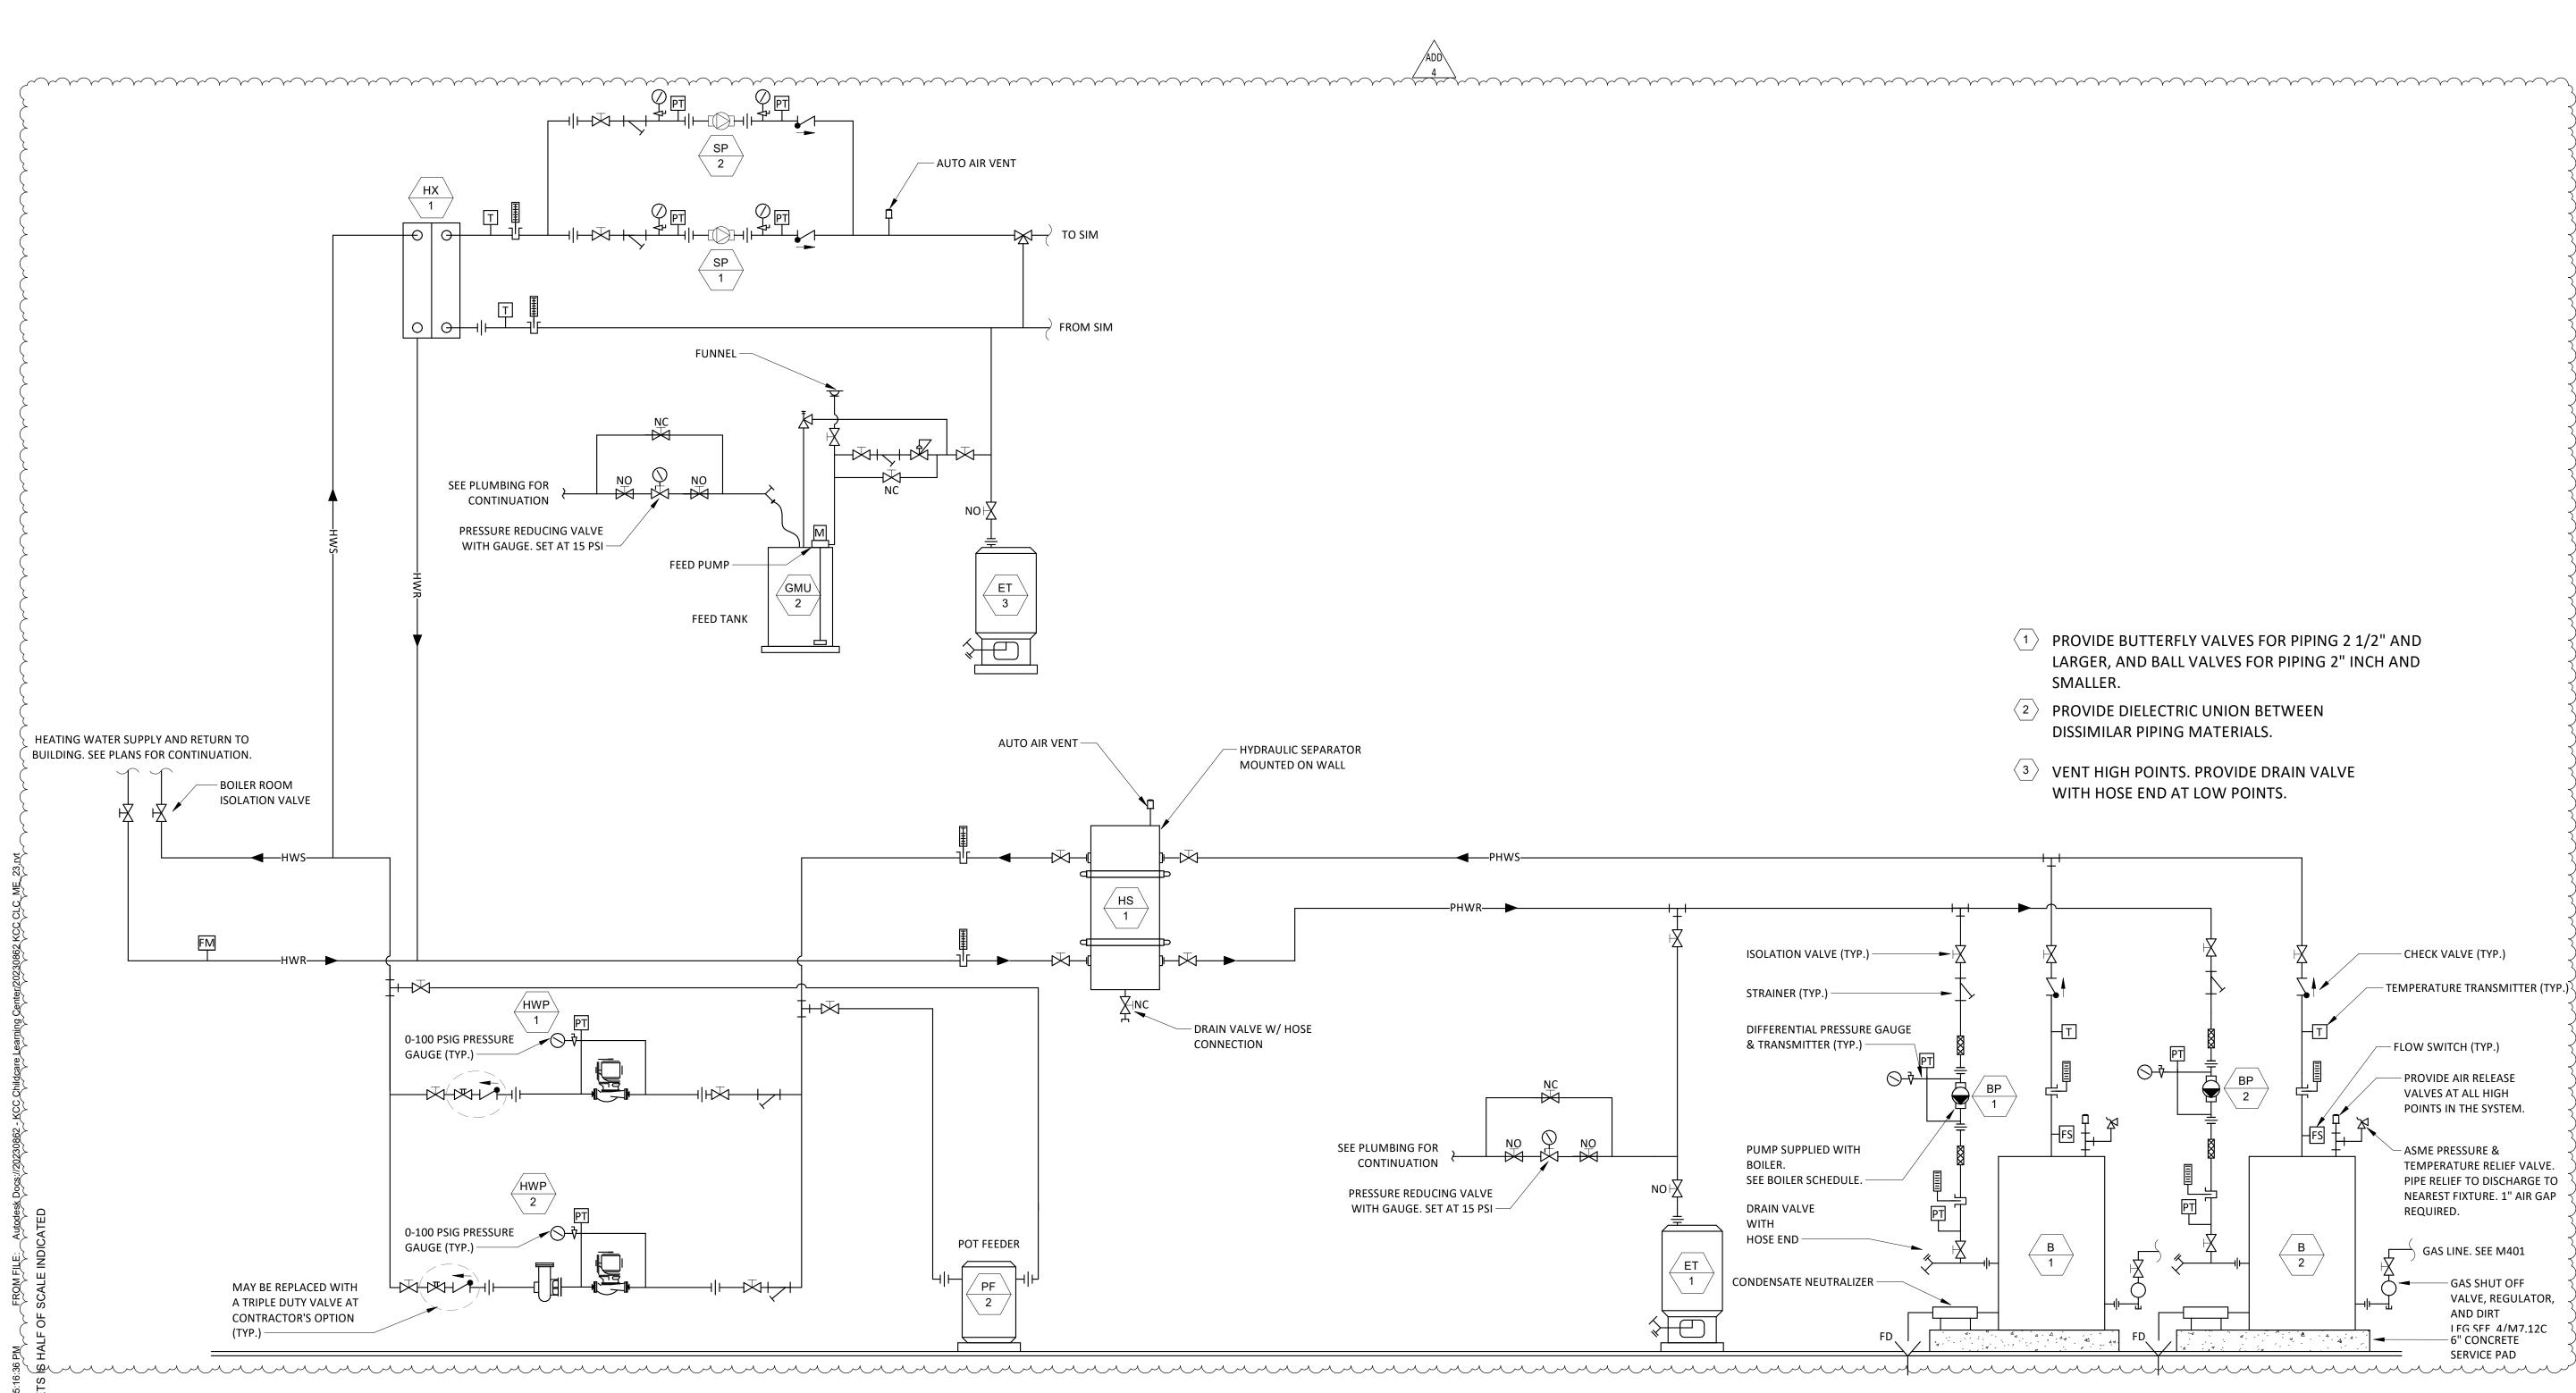

HOT WATER PIPING DIAGRAM

NTS


1 CHILLE M502 12" = 1'-0"



SHEET TITLE: CHILLED **WATER PIPING DIAGRAMS** 

REVISIONS: # DESCRP. ADD 4

ISSUE DATE: 08/26/2025

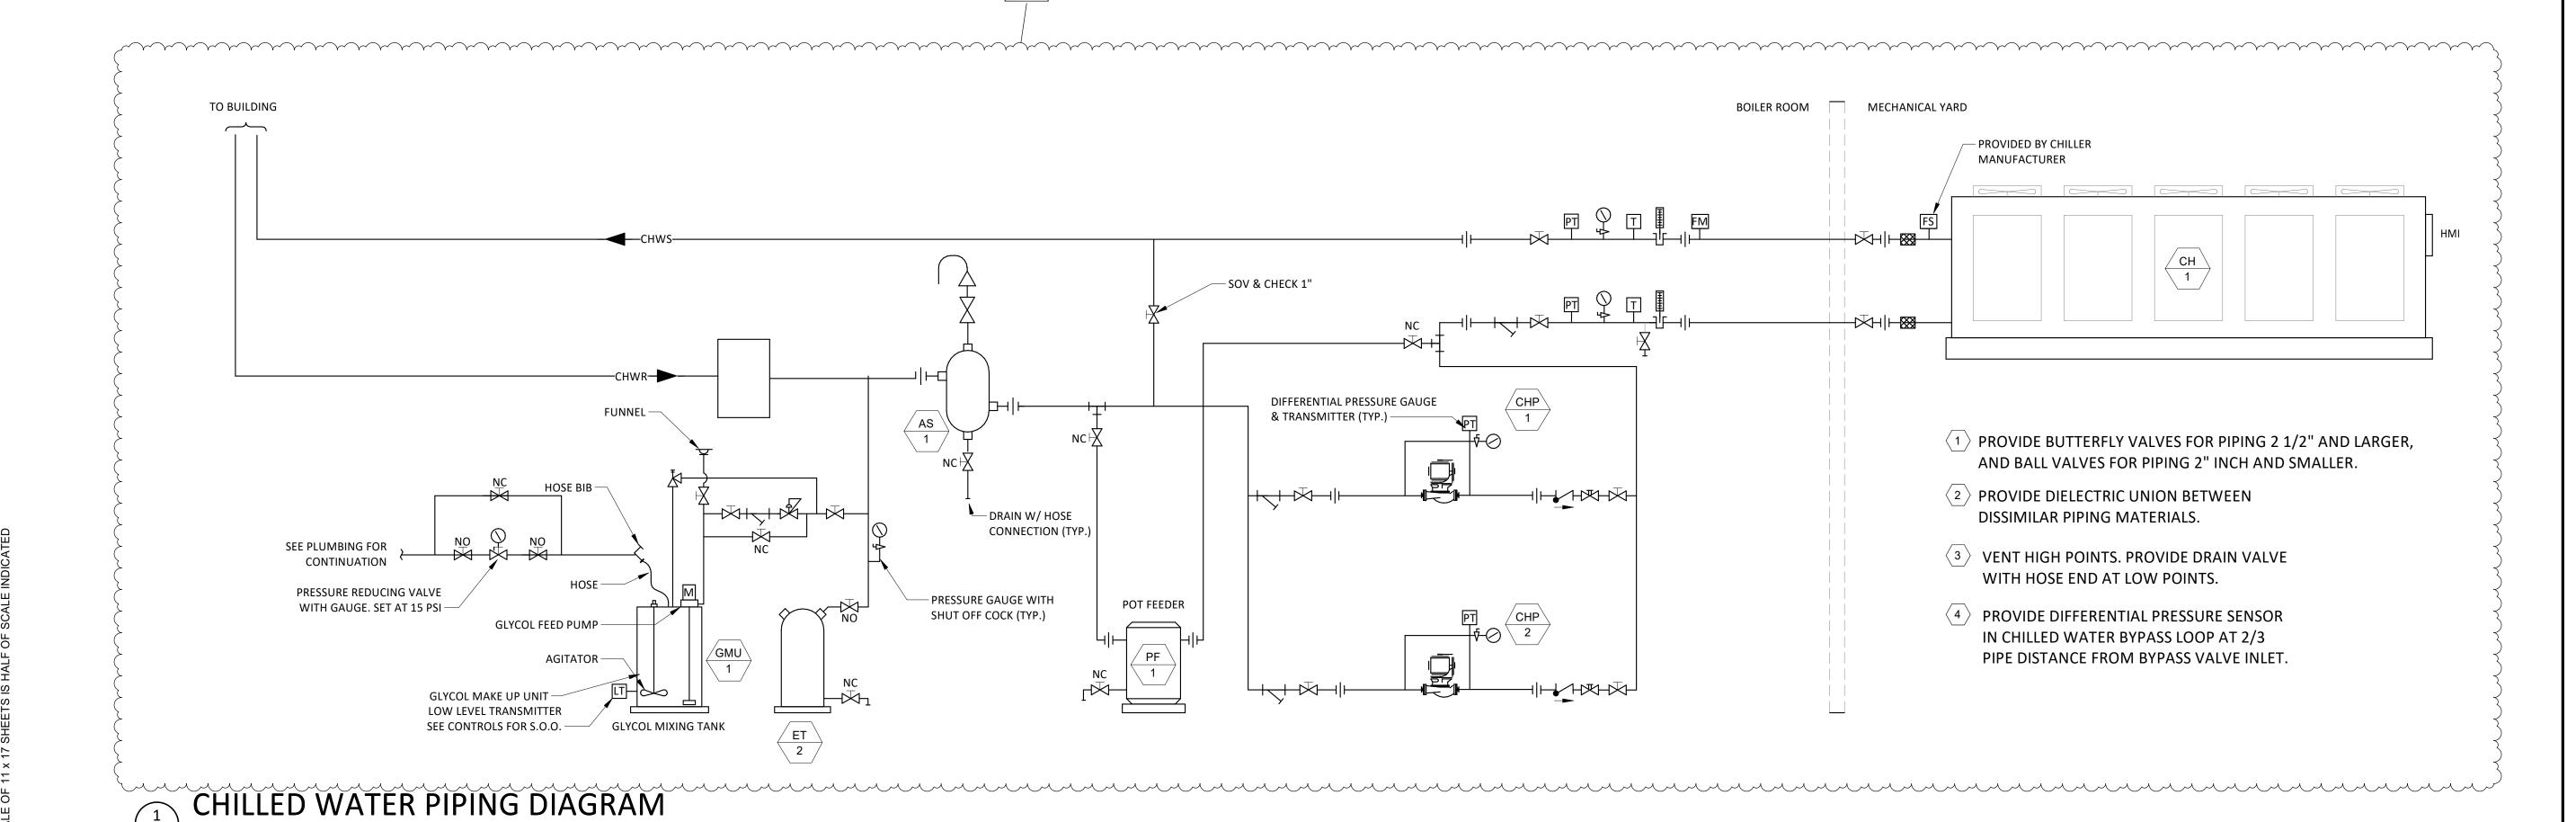

### DOAS UNITS

DOAS UNITS - SEQUENCE OF OPERATION & BAS INTERFACE

- DOAS UNITS WILL BE PROVIDED WITH FIELD CONTROLS BY CONTROLS CONTRACTOR TO CONTROL ALL DOAS UNIT COMPONENTS INCLUDING SUPPLY FANS, EXHAUST FANS, ENERGY RECOVERY WHEEL, AND COIL CONTROL VALVES. PROVIDE A COMPLETE SYSTEM TO CONTROL ALL UNIT FUNCTIONS INCLUDING TEMPERATURE CONTROL, SCHEDULING, MONITORING, UNIT SAFETY PROTECTION, AND DIAGNOSTICS. THE SYSTEM SHALL CONSIST OF ALL REQUIRED TEMPERATURE SENSORS, PRESSURE SENSORS, AND CONTROLLERS.
- THE BUILDING AUTOMATION SYSTEM (BAS) WILL SEND OCCUPIED, UNOCCUPIED, OPTIMAL START, NIGHT HEAT / COOL AND TIMED OVERRIDE COMMANDS. THE BAS WILL SEND DISCHARGE AIR TEMPERATURE SETPOINT AND DUCT STATIC PRESSURE SETPOINT. IF COMMUNICATIONS IS LOST WITH THE BAS, THE CONTROLLER WILL OPERATE IN THE OCCUPIED HEATING MODE USING ITS DEFAULT SETPOINTS.

DURING OCCUPIED PERIODS THE SUPPLY FANS AND EXHAUST FANS WILL RUN CONTINUOUSLY AND THE OUTSIDE AIR DAMPERS AND EXHAUST AIR DAMPERS WILL OPEN TO MAXIMUM POSITIONS. FANS MODULATE SPEED TO MAINTAIN DUCT STATIC PRESSURE AT 0.5" (ADJUSTABLE) BASED ON FEEDBACK FROM DUCT STATIC PRESSURE SENSOR. FINAL DUCT STATIC PRESSURE SETPOINT TO BE DETERMINED DURING TAB. THE ENERGY RECOVERY WHEEL IS ENABLED AND SPEED IS MODULATED VIA VFD AND OUTPUT SIGNAL FROM BAS.

- A. <u>COOLING</u>: a. WHEN THE UNIT IS IN COOLING MODE, CHILLED WATER CONTROL VALVE MODULATES TO MAINTAIN DISCHARGE AIR TEMPERATURE SETPOINT BASED ON RESET SCHEDULE
- RESET SCHEDULE: MINIMUM LEAVING AIR TEMPERATURE OF 55F AT 75F OUTDOOR AIR TEMPERATURE. **HEATING**:
- WHEN THE UNIT IS IN HEATING MODE, HEATING WATER CONTROL VALVE MODULATES TO MAINTAIN DISCHARGE AIR TEMPERATURE SETPOINT BASED ON RESET SCHEDULE.
- RESET SCHEDULE: MAXIMUM LEAVING AIR TEMPERATURE OF 75F AT 50F OUTDOOR AIR TEMPERATURE.
- A DUCT STATIC PRESSURE TRANSDUCER SHALL BE PROVIDED WITH THE SENSOR LOCATED AT APPROXIMATELY TWO-THIRDS OF THE DISTANCE OF THE TOTAL SUPPLY DUCT LENGTH. FAN SPEEDS WILL BE MODULATED TO MAINTAIN STATIC PRESSURE SETPOINT.
- **BUILDING STATIC PRESSURE**
- A DIFFERENTIAL PRESSURE TRANSDUCER SHALL ACTIVELY MONITOR THE DIFFERENCE IN PRESSURE BETWEEN THE BUILDING (INDOORS) AND OUTDOORS.
- **DEMAND CONTROL VENTILATION**
- EACH ZONE IS EQUIPPED WITH A CO₂ SENSOR. WHEN ALL ZONES SERVED BY A DOAS UNIT MEASURE CO₂ CONCENTRATIONS BELOW 800 PPM (ADJUSTABLE), THE DOAS SHALL OPERATE AT THE DCV MINIMUM OUTDOOR AIRFLOW. IF ANY ZONE EXCEEDS THE CO2 THRESHOLD OF 800 PPM (ADJUSTABLE) FOR MORE THAN 5 CONTINUOUS MINUTES, THE DOAS SHALL MODULATE OUTDOOR AIRFLOW USING A PID CONTROL LOOP TO GRADUALLY INCREASE FROM THE DCV MINIMUM TO THE DCV MAXIMUM AIRFLOW ONCE ALL ZONE CO<sub>2</sub> LEVELS FALL BELOW THE SETPOINT, THE DOAS SHALL MODULATE AIRFLOW BACK FROST CONTROL
  - THE BAS SHALL MODULATE THE ENERGY WHEEL SPEED VIA VFD TO PREVENT FROST BUILD UP. FROST CONTROL SHALL ENABLE WHEN OAT FALLS BELOW 40°F (ADJ.) AND SHALL REDUCE WHEEL SPEED AS REQUIRED TO MAINTAIN EXHAUST-AIR LEAVING WHEEL TEMPERATURE (EALWT) AT OR ABOVE 34°F (ADJ.). IF EALWT CANNOT BE MAINTAINED AT MINIMUM WHEEL SPEED, THE WHEEL SHALL CYCLE OFF INTERMITTENTLY

<u> UNDECUPIED (NIGHT SETBACK)</u>:

WHEN OCCUPIED, SUPPLY FANS SHALL SHUT DOWN WHENEVER THE RELATED DUCT SMOKE DETECTOR ALARMS, AND WHEN ANY OTHER SMOKE DETECTOR IN THE AREA SERVED BY THE DOAS UNIT ALARMS.

FILTER STATUS A DIFFERENTIAL PRESSURE SWITCH WILL MONITOR THE DIFFERENTIAL PRESSURE ACROSS THE FILTER WHEN THE FAN IS RUNNING. IF THE SWITCH CLOSES DURING NORMAL OPERATION A DIRTY FILTER ALARM WILL BE ANNUNCIATED. <u>ALARMS</u>:

AT A MINIMUM, PROVIDE UNIT FAILURE, SUPPLY FAN FAILURE, EXHAUST FAN FAILURE, HIGH / LOW SUPPLY AIR TEMPERATURE, HIGH / LOW SUPPLY AIR STATIC PRESSURE, CONDENSATE OVERFLOW, HIGH / LOW STATIC PRESSURE, DIRTY FILTER.

<u>UNIT STATUS:</u> AT A MINIUM, PROVIDE STATUS OF UNIT MODE, ENERGY RECOVERY WHEEL, FANS, AND DAMPERS

# DOMESTIC HOT WATER

DOMESTIC HOT WATER - SEQUENCE OF OPERATION & BAS INTERFACE

- LEAD/LAG OPERATION: PROVIDE AUTOMATIC LEAD/LAG CONTROL FOR TWO (2) PUMPS. ONLY ONE (1) PUMP SHALL
- MONTHLY ALTERNATION: ALTERNATE LEAD PUMP SELECTION MONTHLY TO BALANCE RUN TIMES.
- FAILURE ALARM & SWITCHOVER: UPON FAILURE OF THE OPERATING PUMP, AUTOMATICALLY SWITCH TO THE STANDBY PUMP AND GENERATE A PUMP FAILURE ALARM AT THE BMS. OCCUPANCY-BASED ENABLE/DISABLE: ENABLE PUMPS BASED ON THE BUILDING OCCUPANCY SCHEDULE; DISABLE WHEN
- UNOCCUPIED.
- TEMPERATURE CONTROL: PROVIDE A RETURN WATER TEMPERATURE SENSOR. TURN PUMPS OFF WHEN RETURN TEMPERATURE IS ABOVE THE SETPOINT; ENABLE THEM WHEN RETURN TEMPERATURE DROPS BELOW SETPOINT.
  - RESPONSIBILITIES: BMS CONTRACTOR: FURNISH TEMPERATURE SENSORS, CONTROL RELAYS, AND NECESSARY INTERFACE POINTS.
  - PROVIDE PROGRAMMING FOR LEAD/LAG CONTROL, ALARM, AND SCHEDULING.
  - PLUMBER: INSTALL PUMPS, TEMPERATURE SENSOR WELLS, AND PIPING AS INDICATED.
- ELECTRICIAN: PROVIDE POWER WIRING, AND IF SPECIFIED, CONDUIT FOR CONTROL WIRING.

### **SNOW MELT**

SNOW MELT - SEQUENCE OF OPERATION & BAS INTERFACE

GENERAL: CONTRACTOR SHALL PROVIDE A COMPLETE SYSTEM OF CONTROLS TO ENABLE A FULLY FUNCTIONAL SNOW MELT SYSTEM TO BE CONNECTED TO THE BUILDING AUTOMATION SYSTEM (BAS).

- A. SNOW MELT PUMPS SHALL BE CONTROLLED BY THE BAS.
- HEAT EXCHANGER (HX) CONTROL VALVE SHALL BE CONTROLLED BY THE BAS. CONTROL VALVE SHALL BE 100% CLOSED WHENEVER THE ICE/SNOW CONDITION IS CLEARED AND THE OAT IS ABOVE 32 DEG F (ADJ.).
- UPON A CALL FOR HEAT FROM THE ZONE SLAB SENSOR FROM ICE OR SNOW, CIRCULATION PUMP SHALL BE ENERGIZED AND THE HEATING WATER VALVES SHALL BE MODULATED TO MAINTAIN 120 DEG F (ADJ.) SUPPLY TEMPERATURE TO THE SNOW MELT SYSTEM. THE SUPPLY TEMPERATURE SHALL BE MAINTAINED AND THE PUMP SHALL OPERATE UNTIL 30 MINUTES (ADJ.) PAST THE ICE/SNOW CONDITION BEING CLEARED.

# KITCHEN MECHANICAL EQUIPMENT

KITCHEN MECHANICAL EQUIPMENT - SEQUENCE OF OPERATION & BAS INTERFACE

GENERAL: MECHANICAL SYSTEM CONSISTS OF TYPE 1 GREASE EXHAUST FAN (KEF), MAKEUP AIR UNIT (MAU), GREASE HOOD, HOOD CONTROL PANEL, DUCT TEMPERATURE SENSOR, AND ROOM TEMPERATURE SENSOR. HOOD CONTROL PANEL AND MAKEUP AIR UNIT CONTROLLER BY CAPTIVEAIRE. SEE FOOD SERVICE DRAWINGS FOR DETAILS, CONTROL SEQUENCE, AND ADDITIONAL REQUIREMENTS. CAPTIVEAIRE CONTROLLERS SHALL BE INTEGRATED TO BAS VIA BACNET.

- KITCHEN HOOD EXHAUST FAN (KEF) SHALL OPERATE ACCORDING TO AUTOMATIC, MANUAL, SCHEDULED, OR FIRE COMMANDS FROM HOOD CONTROL PANEL.
- MAKEUP AIR UNIT (MAU) SHALL BE INTERLOCKED TO THE KITCHEN HOOD EXHAUST FAN (KEF-01) AND SHALL PROVIDE MAKEUP AIR TO THE HOOD WHEN IN OPERATION. MAKEUP AIR UNIT SHALL ALSO PROVIDE SPACE CONDITIONING.
- C. BAS SHALL MONITOR THE STATUS OF KEF AND MAU, AND GENERATE AN ALARM UPON A FAILURE TO RUN CONDITION

### **HEATING WATER SYSTEM**

HEATING WATER SYSTEM CONTROL SEQUENCE (B-1, B-2, BP-1, BP-2, HWP-1, HWP-2)

- BOILERS INCORPORATE INTEGRAL TEMPERATURE AND SAFETY CONTROLS. DDC SYSTEM INTERFACES TO BOILER THROUGH BACNET NETWORK, BOILERS AND PUMPS ARE CONTROLLED BY THE BUILDING AUTOMATION SYSTEM (BAS).
- BOILERS (B-1, B-2)
- a. BOILERS SHALL BE ENABLED WHENEVER:
  - A PERCENTAGE OF ZONES CALL FOR HEATING (10%, ADJ.) AND THE OUTSIDE AIR TEMPERATURE IS BELOW 75F (ADJ.)
- b. THE BOILER SHALL BE ENABLED A USER ADJUSTABLE TIME AFTER BOILER PUMP STATUS IS PROVEN ON. DELAY ON START SHALL BE ADJUSTABLE.
- BOILER SHALL NOT BE ENABLED UNTIL FLOW THROUGH BOILER IS PROVEN BY THE FLOW SWITCH AND SAFETY
- INTERLOCKS ARE PROVEN (LOW WATER, BLOCKED FLUE, HIGH LIMIT, AIRFLOW, GAS PRESSURE)
- BOILERS OPERATE AND MODULATE BURNERS TO MAINTAIN HOT WATER SUPPLY TEMPERATURE. BOILER SHALL AUTOMATICALLY FIRE AS MANY STAGES OF HEATING AS NECESSARY TO MEET HEATING DEMAND.
- BOILERS OPERATE IN CASCADING CONFIGURATION TO PROVIDE EVEN OPERATING HOURS. IF A BOILER FAILS, SHUTDOWN ASSOCIATED BOILER PUMP AND DISABLE CASCADING MODE.
- BOILER PUMPS (BP-1, BP-2)
- BOILER PUMPS SHALL RUN ANYTIME THE BOILERS ARE CALLED TO RUN.
- THE BOILER PUMPS SHALL START PRIOR TO THE BOILERS BEING ENABLED AND SHALL STOP ONLY AFTER THE BOILERS ARE DISABLED. DELAY ON START AND DELAY ON STOP SHALL BE ADJUSTABLE.
- IF A BOILER PUMP FAILS, SHUTDOWN ASSOCIATED BOILER AND DISABLE CASCADING MODE.
- MODULATE THE BOILER PUMP SPEED AS HEATING DEMAND VARIES.
- HEATING WATER PUMPS (HWP-1, HWP-2)
- ON A CALL FOR HEAT, LEAD HEATING WATER PUMP IS AUTOMATICALLY STARTED.
- VFD SHALL MODULATE PUMP SPEED BASED ON FEEDBACK FROM DIFFERENTIAL PRESSURE TRANSMITTER TO MAINTAIN CONSTANT DIFFERENTIAL PRESSURE.
- IF FLOW FROM LEAD HEATING WATER PUMP IS NOT SUFFICIENT, LAG SECONDARY PUMP IS STARTED, AND BOTH PUMPS MODULATE IN UNISON TO MAINTAIN DIFFERENTIAL SETPOINT.
- BAS SHALL AUTOMATICALLY ROTATE LEAD HEATING WATER PUMP ON A WEEKLY BASIS (ADJ.)
- RESET SYSTEM DIFFERENTIAL PRESSURE IN RESPONSE TO SYSTEM FLOWRATE. HEATING WATER SUPPLY TEMPERATURE
- THE HEATING WATER SUPPLY TEMPERATURE SETPOINT SHALL BE RESET USING A TRIM AND RESPOND ALGORITHM IN RESPONSE TO THE BUILDING'S HEATING DEMANDS TO REDUCE HEATING ENERGY USE.
- THE HEATING WATER SUPPLY TEMPERATURE SETPOINT SHALL BE RESET BASED ON OUTDOOR AIR TEMPERATURE.
- THE BOILER PUMPS SHALL NOT TURNDOWN LESS THAN MINIMUM BOILER FLOW (15 GPM, ADJ.) SEE BOILER **SCHEDULE**
- SAFETY AND ALARMS a. IF THE BOILER EXPERIENCES A FAULT CONDITION, SHUT DOWN THE BOILER AND PUMPS, AND GENERATE AN
- THE BOILER SHALL INCLUDE A FACTORY MOUNTED FLOW SWITCH TO MONITOR PROOF OF FLOW FOR
- EQUIPMENT START AND LOSS OF FLOW / LOW FLOW FOR EQUIPMENT SHUTOFF.
- IF THERE IS NO BUILDING HEATING DEMAND FOR MORE THAN AN ADJUSTABLE PROGRAMMED TIME LIMIT (15 MIN, ADJ.), SHUTDOWN THE BOILER AND PUMPS.

ALARMS:

- BOILER FAILURE **BOILER PUMP FAILURE**
- HEATING WATER PUMP FAILURE
- HIGH / LOW SUPPLY WATER TEMPERATURE
- HIGH / LOW DIFFERENTIAL PRESSURE
- LOW FLOW (FLOW SWITCH) GRAPHIC DISPLAY:
- OUTDOOR AIR TEMPERATURE
- DIFFERENTIAL SYSTEM PRESSURE
- DIFFERENTIAL SYSTEM PRESSURE SETPOINT HEATING WATER RETURN TEMPERATURE
- HEATING WATER SUPPLY TEMPERATURE
- HEATING WATER SUPPLY TEMPERATURE SETPOINT
- **BOILER STATUS BOILER PUMP STATUS**
- BOILER PUMP SPEED
- **HEATING WATER PUMP STATUS HEATING WATER PUMP SPEED**
- OPERATING HOURS
- TREND LOGS ALARM HISTORY

### **ENERGY METERING**

**ENERGY METERING - SEQUENCE OF OPERATION & BAS INTERFACE** 

- A. ENERGY METERING SHALL COMPLY WITH REQUIREMENTS OF ASHRAE 90.1 SECTION 8.4.3.
- ELECTRICAL CONTRACTOR SHALL PROVIDE REMOTE METERING CAPABILITY. MONITOR THE ELECTRICAL ENERGY USE FOR EACH OF THE FOLLOWING SEPARATELY
- TOTAL ELECTRICAL ENERGY
- **HVAC SYSTEMS**
- INTERIOR LIGHTING
- EXTERIOR LIGHTING RECEPTACLE CIRCUITS
- THE ELECTRICAL ENERGY USE FOR ALL LOADS SPECIFIED ABOVE SHALL BE RECORDED A MINIMUM OF EVERY 15 MINUTES AND REPORTED HOURLY, DAILY, MONTHLY, AND ANNUALLY.
- ENERGY USE DATA AS SPECIFIED ABOVE SHALL BE TRANSMITTED TO THE BAS AND GRAPHICALLY DISPLAYED. DATA SHALL BE MAINTAINED FOR A MINIMUM OF 36 MONTHS.

# **OUTDOOR AIR SENSOR**

OUTSIDE AIR TEMPERATURE AND HUMIDITY - SEQUENCE OF OPERATION & BAS INTERFACE

- A. PROVIDE OUTSIDE AIR TEMPERATURE SENSOR AND OUTSIDE AIR HUMIDITY SENSOR. MOUNT ON NORTH WALL OF
- BAS SHALL MONITOR OUTSIDE AIR TEMPERATURE AND HUMIDITY.
- OUTSIDE AIR CONDITIONS SHALL BE VISIBLE ON THE GRAPHICAL USER INTERFACE, AND TRENDED FOR DIAGNOSTIC

### **ELECTRIC HEATERS**

**ELECTRIC HEATERS - SEQUENCE OF OPERATION & BAS INTERFACE** 

- ELECTRIC HEATERS OPERATE VIA A FACTORY BUILT-IN THERMOSTAT. HEATER SHALL MODULATE TO MEET SPACE TEMPERATURE SETPOINT
- a. INITIAL SETPOINT: 60 DEG F (ADJUSTABLE).
- EACH SPACE THAT HAS A HEATER WILL BE EQUIPPED WITH ADDITIONAL BAS CONNECTED SPACE TEMPERATURE SENSOR WHICH WILL GENERATE LOW SPACE TEMPERATURE ALERTS.
- ALARMS: AT A MINIMUM, PROVIDE LOW SPACE TEMPERATURE.

# CHILLED WATER SYSTEM

CHILLED WATER SYSTEM CONTROL SEQUENCE (CH-1, CHP-1, CHP-2):

- 1. AIR-COOLED CHILLER INCORPORATES INTEGRAL TEMPERATURE AND SAFETY CONTROLS. DDC SYSTEM INTERFACES TO CHILLER THROUGH BACNET NETWORK.
- CHILLER (CH-1)
- a. THE CHILLER SHALL BE ENABLED WHENEVER:
- A PERCENTAGE OF ZONES CALL FOR COOLING (20%, ADJ.)
- AND THE OUTSIDE AIR TEMPERATURE IS GREATER THAN 54F (ADJ.)
- THE CHILLER SHALL RUN FOR AND BE OFF FOR MINIMUM ADJUSTABLE TIMES TO PREVENT SHORT CYCLING, UNLESS SHUTDOWN ON SAFETIES OR OUTSIDE AIR CONDITIONS.
- THE CHILLER SHALL BE ENABLED A USER ADJUSTABLE TIME AFTER PUMP STATUS IS PROVEN ON. DELAY ON START SHALL BE ADJUSTABLE
- CHILLER OPERATES AND MODULATES COMPRESSORS TO MAINTAIN CHILLED WATER SUPPLY TEMPERATURE. CHILLED WATER PUMPS (CHP-1, CHP-2)
- CHILLED WATER PUMP SHALL RUN ANYTIME THE CHILLER IS CALLED TO RUN. CHILLED WATER PUMP SHALL ALSO RUN FOR FREEZE PROTECTION WHENEVER THE OUTSIDE AIR TEMPERATURE IS LESS THAN A USER DEFINABLE
- THE CHILLED WATER PUMP SHALL START PRIOR TO THE CHILLER BEING ENABLED AND SHALL STOP ONLY AFTER THE CHILLER IS DISABLED. DELAY ON START AND DELAY ON STOP SHALL BE ADJUSTABLE.
- CHILLED WATER PUMPS OPERATE IN A LEAD / LAG CONFIGURATION. WHEN CHILLED WATER SYSTEM IS ON, ONE PUMP IS REQUIRED TO OPERATE. START PUMP WITH LOWEST RUNTIME (UNLESS IT HAS FAILED) OR HAS BEEN DESIGNATED OUT OF SERVICE, AND ROTATE PUMPS ON A WEEKLY BASIS.
- IF OPERATING PUMP FAILS, IMMEDIATELY START BACKUP PUMP. MODULATE THE CHILLED WATER PUMP SPEED TO MAINTAIN A DIFFERENTIAL PRESSURE SETPOINT (ADJ.) IN THE CHILLED WATER LOOP. FINAL SETPOINT DETERMINED DURING TAB.
- CHILLED WATER SUPPLY TEMPERATURE THE CHILLED WATER SUPPLY TEMPERATURE SETPOINT SHALL RESET USING A TRIM AND RESPOND ALGORITHM IN RESPONSE TO THE BUILDING'S COOLING DEMANDS TO REDUCE COOLING ENERGY USE.
- MINIMUM FLOW THE BAS SHALL MONITOR DIFFERENTIAL PRESSURE BETWEEN ENTERING AND LEAVING CHILLED WATER AT THE CHILLER EVAPORATOR AND SHALL MAINTAIN A MINIMUM PRESSURE DROP ACROSS THE CHILLER EVAPORATOR CORRESPONDING TO MINIMUM FLOW WHEN THE CHILLED WATER PUMP IS ENABLED AND THE CHILLER IS

THE MINIMUM PRESSURE DROP SHALL CORRESPOND TO CHILLER MANUFACTURER'S SPECIFIED MINIMUM

CHILLED WATER FLOW AND SHALL BE MAINTAINED BY THE CHILLED WATER SYSTEM LOW FLOW BYPASS CONTROL

- VALVE INSTALLED IN THE FIELD PIPING. DURING LOW FLOW OPERATIONS WITH CHILLER ENABLED, THE BYPASS CONTROL VALVE SHALL MODULATE OPEN TO MAINTAIN MINIMUM CHILLED WATER FLOW REQUIREMENTS AT CHILLER EVAPORATOR.
- IF THE CHILLER EXPERIENCES A FAULT CONDITION, SHUT DOWN THE CHILLER AND GENERATE AN ALARM
- NOTIFICATION. IF THE CHILLED WATER PUMP FAILS TO MAINTAIN FLOW, INITIATE A BACKUP PUMP AND GENERATE AN ALARM
- THE CHILLER SHALL INCLUDE A FACTORY MOUNTED FLOW SWITCH TO MONITOR PROOF OF FLOW FOR EQUIPMENT START AND LOSS OF FLOW / LOW FLOW FOR EQUIPMENT SHUTOFF.
- IF THERE IS NO BUILDING COOLING DEMAND FOR MORE THAN AN ADJUSTABLE PROGRAMMED TIME LIMIT (15

MIN, ADJ.), SHUTDOWN THE CHILLER AND CHILLED WATER PUMP

DIFFERENTIAL PRESSURE ACROSS CHILLER EVAPORATOR.

- ALARMS:
- a. CHILLER FAILURE
- PUMP FAILURE
- HIGH / LOW SUPPLY WATER TEMPERATURE
- HIGH / LOW SYSTEM PRESSURE LOW FLOW (FLOW SWITCH)
- GRAPHIC DISPLAY: OUTDOOR AIR TEMPERATURE
- DIFFERENTIAL PRESSURE ACROSS SUPPLY AND RETURN PIPING. ~d!~~@HILLED-WATER\RETURN\TEMPERATURE~~~~~~~~
- CHILLED WATER SUPPLY TEMPERATURE
- CHILLED WATER SUPPLY TEMPERATURE SETPOINT CHILLER KW
- **OPERATING HOURS** CHILLED WATER FLOW STATUS
- CHILLED WATER PUMP STATUS

TREND LOGS

- CHILLED WATER PUMP SPEED CHILLER STATUS
- ALARM HISTORY

# **FAN COIL UNITS**

FAN COIL UNITS - SEQUENCE OF OPERATION & BAS INTERFACE GENERAL: CONSTANT VOLUME FOUR-PIPE FAN COIL UNIT WITH VENTILATION AIR PROVIDED BY DOAS UNIT. FAN COIL UNITS WILL BE PROVIDED WITH FIELD CONTROLS BY CONTROLS CONTRACTOR TO CONTROL ALL FAN COIL UNIT

- FUNCTIONS INCLUDING TEMPERATURE CONTROL, SCHEDULING, MONITORING, UNIT SAFETY PROTECTION, AND DIAGNOSTICS. THE SYSTEM SHALL CONSIST OF ALL REQUIRED SENSORS AND CONTROLLERS. EACH FAN COIL UNIT IS PROVIDED WITH AN ELECTRONIC ZONE THERMOSTAT.
- THE BUILDING AUTOMATION SYSTEM (BAS) WILL SEND OCCUPIED, UNOCCUPIED, OPTIMAL START, NIGHT HEAT / COOL AND TIMED OVERRIDE COMMANDS. THE BAS WILL SEND DISCHARGE AIR TEMPERATURE SETPOINT.
- DURING OCCUPIED PERIODS THE SUPPLY FAN WILL RUN CONTINUOUSLY. COOLING: 75 DEG F ZONE SETPOINT (ADJ.) WHEN THE UNIT IS IN COOLING MODE, CHILLED WATER CONTROL VALVE MODULATES TO MAINTAIN DISCHARGE AIR TEMPERATURE SETPOINT TO MAINTAIN ZONE SETPOINT.

COMPONENTS INCLUDING FANS AND COIL CONTROL VALVES. PROVIDE A COMPLETE SYSTEM TO CONTROL ALL UNIT

- <u>HEATING</u>: 70 DEG F ZONE SETPOINT (ADJ.) WHEN THE UNIT IS IN HEATING MODE, HEATING WATER CONTROL VALVE MODULATES TO MAINTAIN DISCHARGE AIR TEMPERATURE SETPOINT TO MAINTAIN ZONE SETPOINT.
- UNOCCUPIED (NIGHT SETBACK): FAN COIL UNIT CYCLES ON AND OFF, AND HEATING AND COOLING CONTROL VALVES ARE MODULATED, TO MAINTAIN UNOCCUPIED SETPOINTS (60 DEG F HEATING, 85 DEG F COOLING).
- AT A MINIMUM, PROVIDE FAN FAILURE, CONDENSATE OVERFLOW.
  - AT A MINIMUM, PROVIDE STATUS OF UNIT MODE, DISCHARGE AIR TEMPERATURE, CONTROL VALVE POSITION.

# **SPLIT SYSTEMS - AIR SOURCE**

SPLIT SYSTEMS - SEQUENCE OF OPERATION & BAS INTERFACE

- 1. DUCTLESS WALL MOUNT FAN COILS OPERATE VIA A FACTORY WALL MOUNT THERMOSTAT PROVIDED BY THE MANUFACTURER TO MAINTAIN SPACE TEMPERATURE IN THE ASSOCIATED AREA. EQUIPMENT OPERATION IS BY LOCAL
- FACTORY CONTROLLER, CONNECTION TO BAS FOR MONITORING ONLY. FAN COIL CYCLES FAN AND COOLING ON AND OFF UPON CALL FOR COOLING. OUTDOOR UNIT MODULATES COMPRESSOR TO MEET COOLING DEMAND. UNIT IS DISABLED WHEN SPACE TEMPERATURE IS SATISFIED.
- WALL MOUNT THERMOSTAT SHALL BE MONITORED BY THE BAS.
- A. INITIAL SETPOINT: 78 DEG F (ADJUSTABLE).
- EACH SPACE THAT HAS A FAN COIL WILL BE EQUIPPED WITH ADDITIONAL BAS CONNECTED SPACE TEMPERATURE SENSOR WHICH WILL GENERATE HIGH OR LOW SPACE TEMPERATURE ALERTS.

ALARMS: AT A MINIMUM, PROVIDE HIGH SPACE TEMPERATURE, LOW SPACE TEMPERATURE, FAN COIL FAILURE,

OUTDOOR UNIT FAILURE. STATUS: AT A MINIMUM, PROVIDE STATUS OF UNIT MODE AND SPACE TEMPERATURE.



SHEET TITLE:

CONTROLS

REVISIONS: DESCRP.

ADD 4

08/29/2025

M601

ISSUE DATE: 08/26/2025



SHEET TITLE: SNOWMELT


**DETAILS** 

REVISIONS: # DESCRP.

ADD 4

ISSUE DATE: 08/26/2025

M703

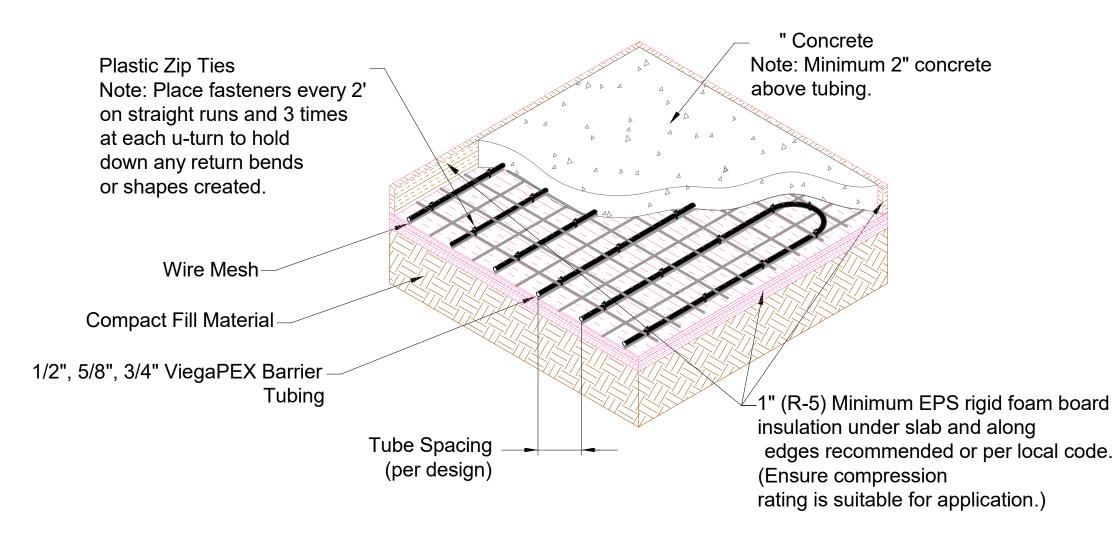

### **SNOW MELTING INSTALLATION - CONCRETE** Plastic Zip Ties

-Concrete Slab:

Minimum 2" thickness of

concrete over ViegaPEX

Barrier Tubing or per local code.

# SNOWMELT SYSTEM SLAB INSTALLATION NTS

Note: Place fasteners every 2'-

on straight runs and 3 times

at each u-turn to hold

down any return bends or shapes created.

